

KERR-MCGEE OIL AND GAS ONSHORE LP

CARLSON V 11-8

SE NE 11 2N 67W 1,915' FNL 794' FEL

WELD,COLORADO

04/01/2015

AREA: W1

ROUTE: W14 Spud: 10/21/1993

WINS No.: H5961

AFE/WO#: 2103357

API#: 0512317511

GL: 4860

KB: 4870

MTD: 7555


TVD: 7555

LOG MD: 7557

PBMD: 7541

PBTVD: 7541

Directions: CR 24 & CR 23, S 3/10, W 1/10, S INTO.

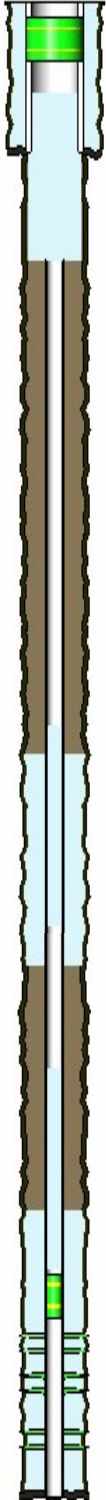

<u>HOLE SECTIONS</u>	<u>Size</u>	<u>Top</u>	<u>Btm</u>	<u>TD Date</u>
SURFACE	12.25	10	609	10/21/1993
PRODUCTION	7.88	609	7557	10/25/1993

<u>TUBULARS</u>	<u>Tool Type</u>	<u>Joints</u>	<u>Size</u>	<u>Weight</u>	<u>Grade</u>	<u>Thread</u>	<u>Top D</u>	<u>Bottom D</u>
SURFACE	Casing	14	8.62	24.00			10	609
BRIDGE PLUG	Cast Iron Bridge Plu	1	2.25		7K		7120	7121
PRODUCTION	Casing	207	2.88	6.50	N-80		1240	7556
BRIDGE PLUG	Cast Iron Bridge Plu	1	8.63				80	82

<u>CEMENT JOBS</u>	<u>Stage</u>	<u>Sacks</u>	<u>Cement Jobs</u>	<u>Top D</u>	<u>Btm D</u>	<u>cbl</u>
SURFACE	PRIM CMT 1ST STAGE	400	Lead REGULAR	10	609	No
PRODUCTION	PRIM CMT 1ST STAGE	212	LEAD LITE	4104	5334	Yes
	PRIM CMT 1ST STAGE	166	TAIL REGULAR	6750	7556	Yes
PRODUCTION	ABANDONMENT PLUC	20	LEAD FRESH WATER	5933	7089	No
PRODUCTION	ABANDONMENT PLUC	30	LEAD FRESH WATER	3944	5100	No
PRODUCTION	ABANDONMENT PLUC	390	LEAD FRESH WATER	270	1235	No

<u>PERFORATIONS</u>	<u>Formation</u>	<u>Zone</u>	<u>Top</u>	<u>Btm</u>	<u>Date</u>	<u>Reason</u>	<u>Comments</u>
	NIOBRARA	A	7172	7191	10/29/1993	PRODUCTION	
	NIOBRARA	B	7235	7278	10/29/1993	PRODUCTION	
	CODELL		7384	7398	12/24/2003	PRODUCTION	
	CODELL		7386	7398	10/29/1993	PRODUCTION	

Comments: