




Exploration and Production TA

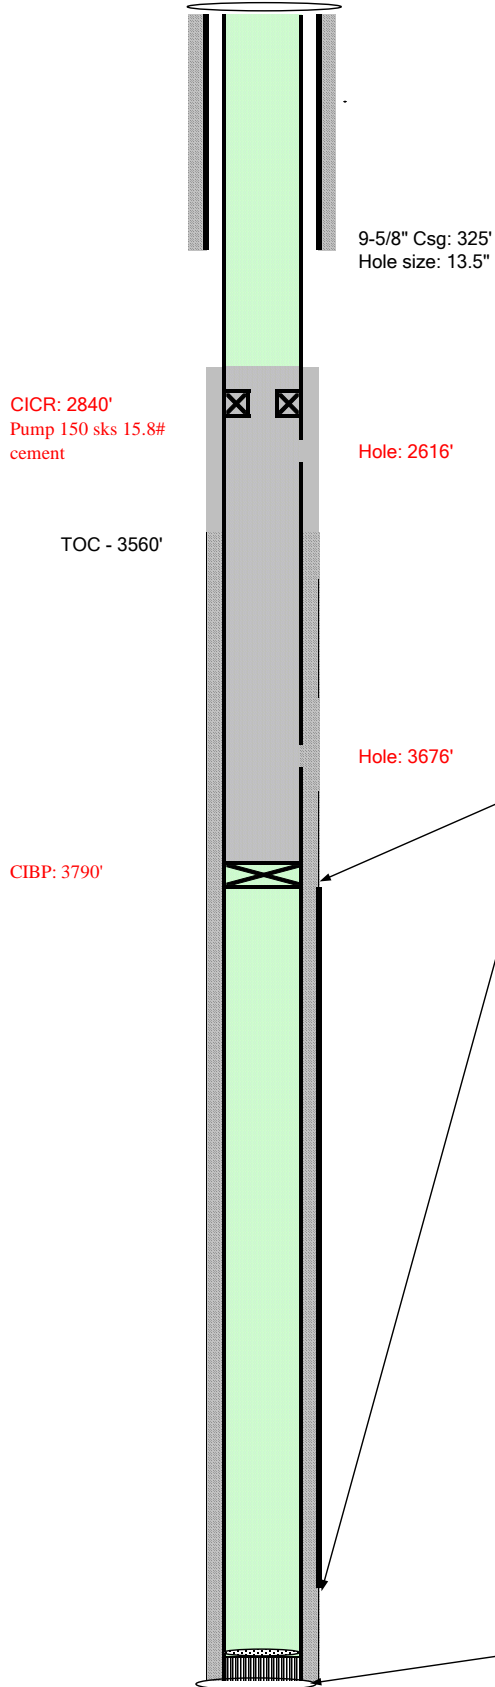

Well Name **GM 31-1**
 Location **NWNE 1 7S 96W**
 Field **Grand Valley**
 County **Garfield, CO**
 API **05-045-07444**
 ELEV **5,380'**
 Footages **233 FNL 2165 FEL**

Spud 1999

Conductor	325'	9-5/8" 36#
Casing	190 sx	Class G
Cement	6643'	4-1/2" 11.6#
Casing	1080 sx	Class G

Tubing **6128'**

Mesaverde
Cameo

TOC - Bond Log **3560'**

Completed Intervals

<u>Depth</u>	<u># Holes</u>
--------------	----------------

<u>MV</u>	3840-6397'
-----------	------------

6643', 4-1/2" Csg, Hole Size, 7-7/8"