



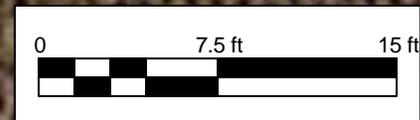

Benzene Concentrations in Milligrams Per Kilogram (mg/kg) Listed Above Soil Sample ID.
TPH Concentrations (mg/kg) Listed Below Soil Sample ID.

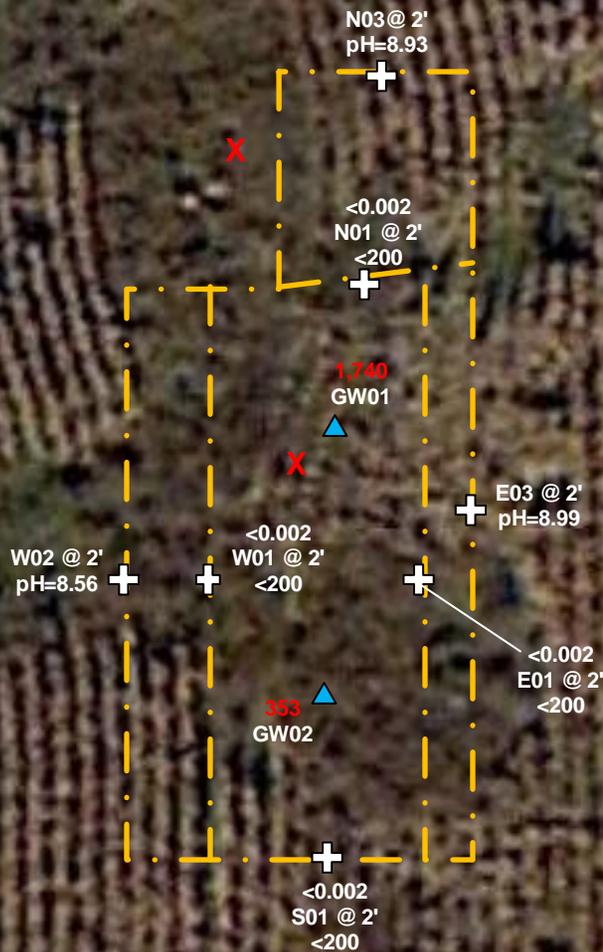

Benzene Concentrations in Micrograms Per Liter (µg/L) Listed Above Groundwater Sample ID.



Surface Drainage



Image Source:
Google Earth 2015

DRAWN BY: BRN
DATE: 4/7/2015

Facility Diagram
Kerr-McGee Oil and Gas Onshore, LP
Richardson V 3-2
NWNE S3 T2N R67W
Weld County, CO



6899 Pecos St., Unit C
Denver, CO 80221

LEGEND

-  Approximate Excavation Extent
-  Approximate Release Location
-  Approximate Soil Sample Location
-  Approximate Groundwater Sample Location

FIGURE 2
SITE AND SAMPLE LOCATION MAP