Frac Wellbore Schematic Report

Well Name: NAKAGAWA PMB13-09

VERTICAL - ORIGINAL HOLE, 4/16/2015 2:44:30 PM

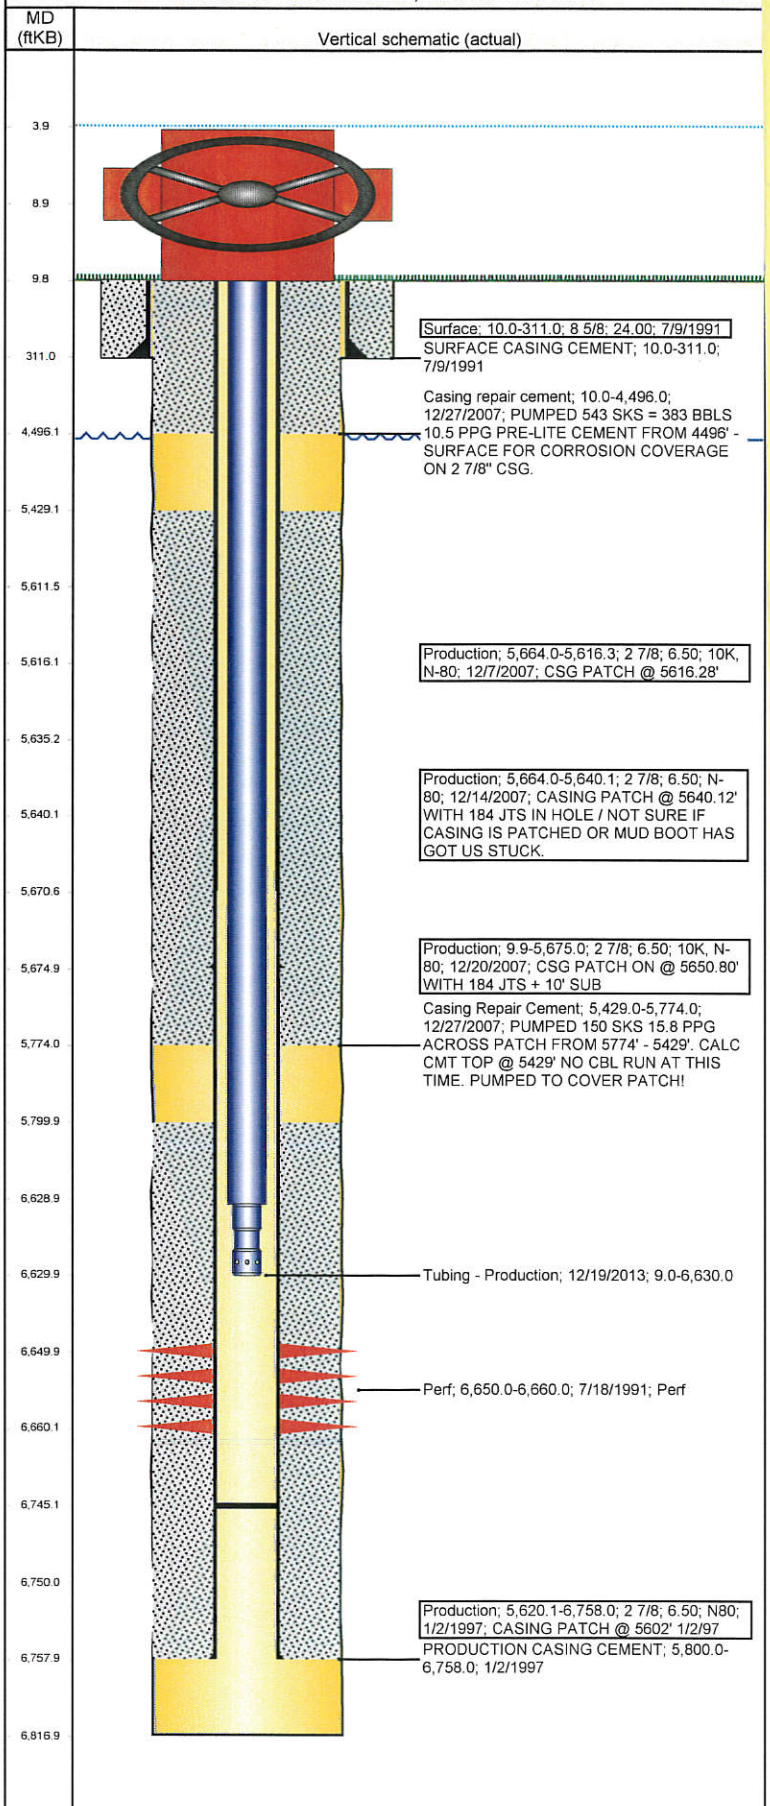

Report Printed: 4/16/2015