



ENCANA OIL & GAS (USA) INC

Wellbore Change Request for Approval

Well : Sprague 3J-9H-N267

Field : DJ Basin

County : Weld

Surf Locat : SESW S9-T2N-R67W

BH Locat : SWSE S4-T2N-R67W

KB Elev : 5,011 ft

Survey : NAD 83

State : CO

Grd Elev : 4,981 ft

API# 05-123-39275

COGCC Document# 400 534 171

Permit Approved: 04/14/2014

Surface Hole Lat: 40.14701 / Long: -104.89831

Bottom Hole Lat: 40.16097 / Long: -104.89230

Wellbore Diagram as of 04/15/2015 (actual)

HOLE SIZE


MD, ft

FORMATION
TOPS

CASING

MUD

CEMENT

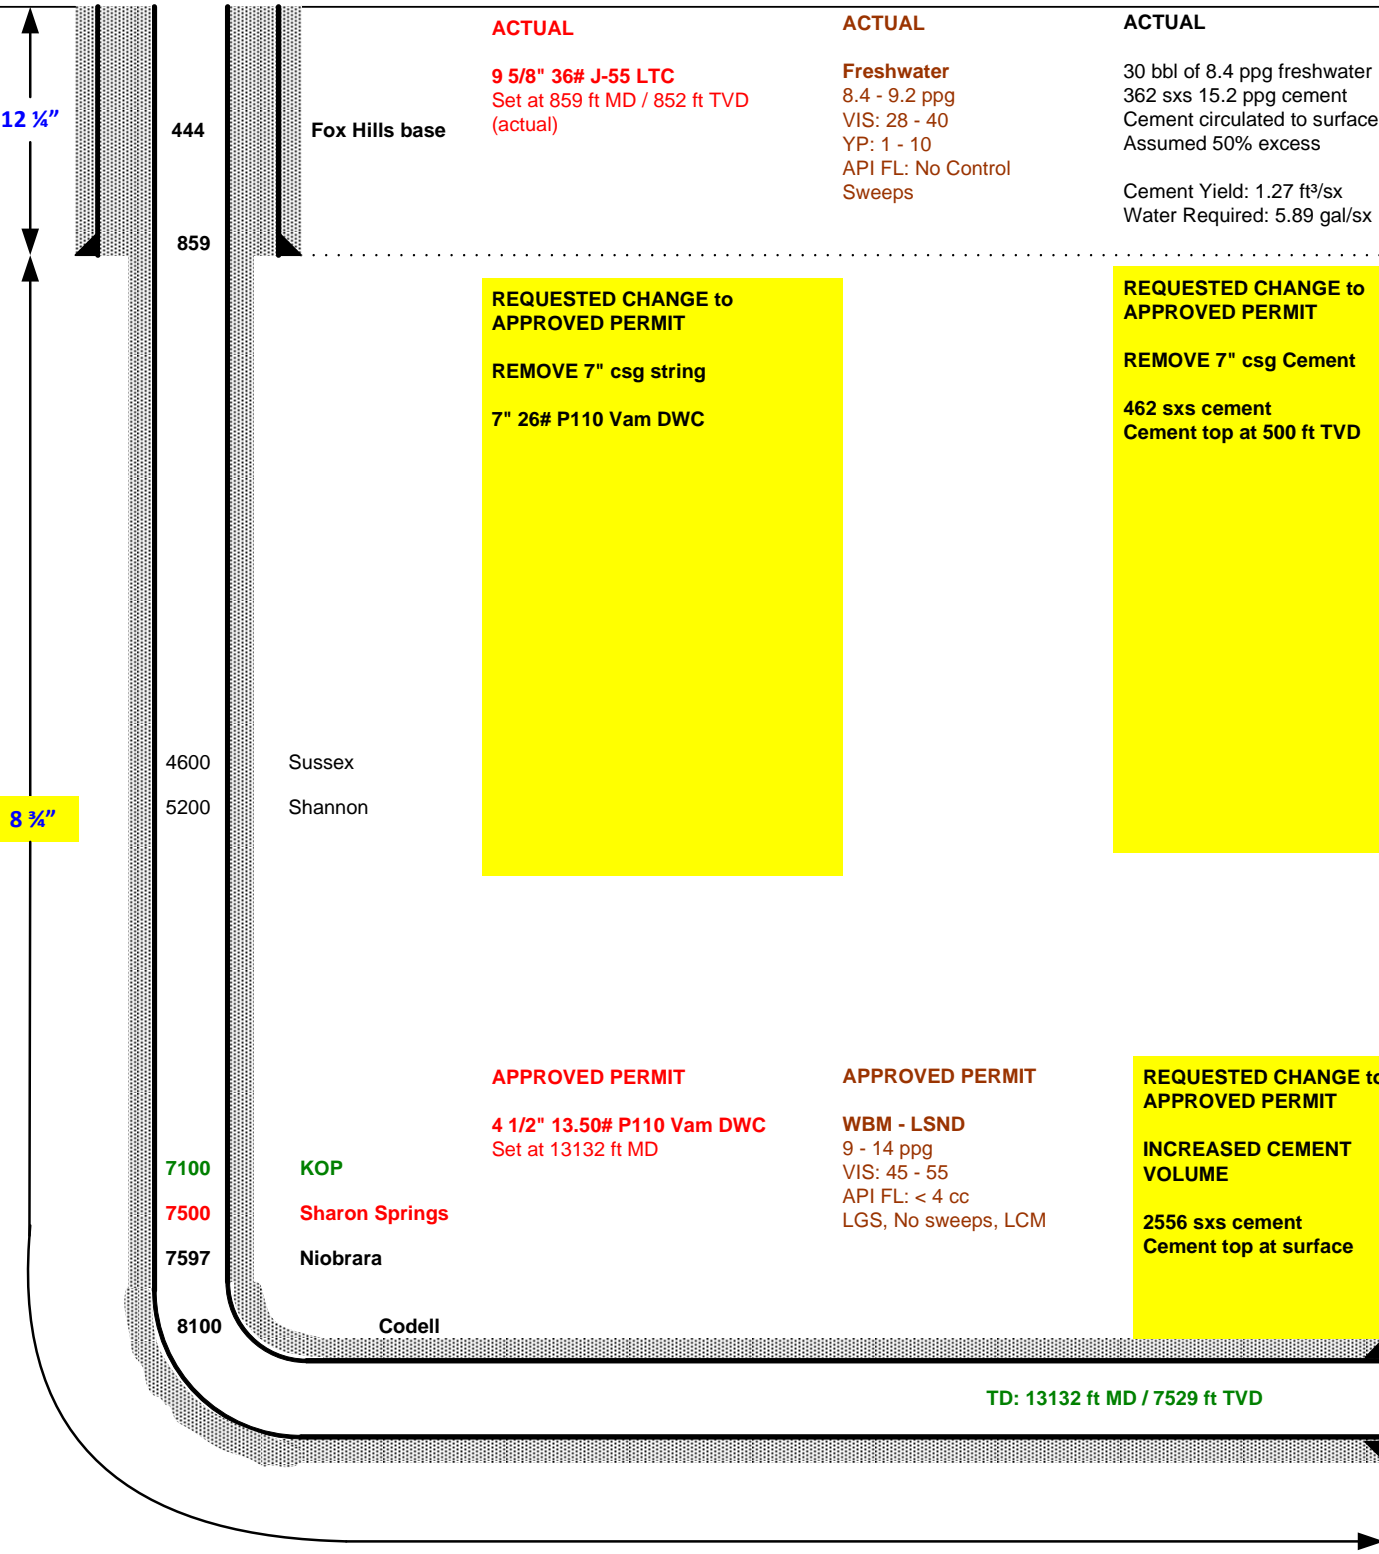

Date:

04/15/2015

Drilling Engineer:

Jerry L Thorstad

Drilling Rig:

PTEN 272