encana natural gas

ENCANA OIL & GAS (USA) INC	Approved Permit Wellbore

Well : Sprague 3J-9H-N267
Field : DJ Basin
County : Weld **State :** CO
Surf Locat : SESW S9-T2N-R67W
BH Locat : SWSE S4-T2N-R67W
KB Elev : 5,011 ft **Grd Elev** : 4,981 ft
Survey : NAD 83

API# 05-123-39275
COGCC Document# 400 534 171
Permit Approved: 04/14/2014

Surface Hole Lat: 40.14701 / Long: -104.89831
Bottom Hole Lat: 40.16097 / Long: -104.89230

Wellbore Diagram as of 04/15/2015 (actual)

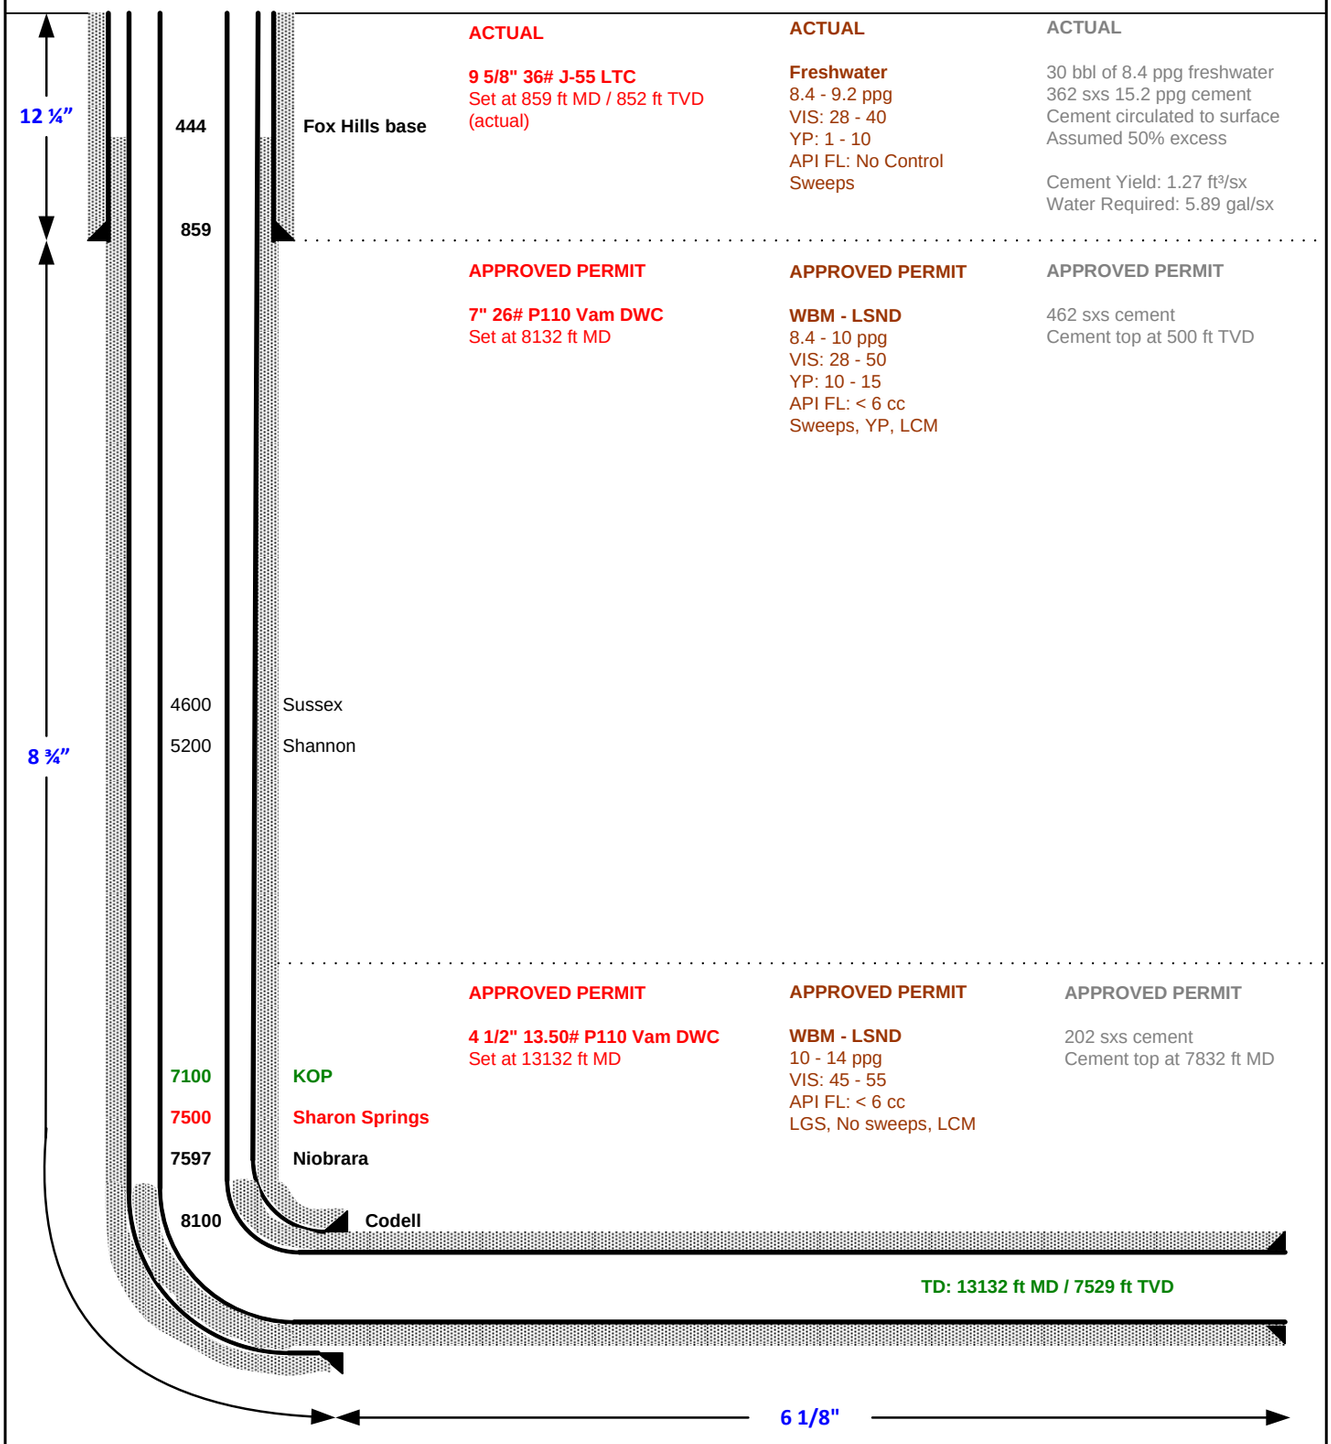

Date:		Drilling Engineer:	Drilling Rig:	
04/15/2015		Jerry L Thorstad	PTEN 272	