



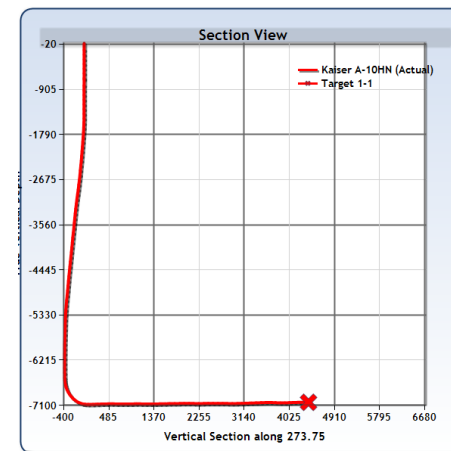

Company: Bayswater Exploration
Well Name: Kaiser A-10HN (Actual)
Location: DJ Basln
Info:
Info:
Vertical Section Calculated on an Azimuth of: 273.7500
Survey Calculation method: Minimum Curvature
File Name: Kaiser A-10HN (Actual).sr6

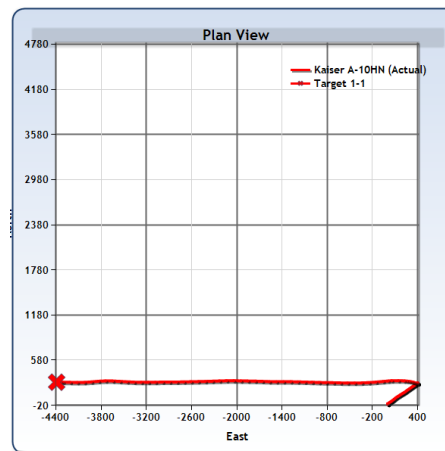

#	Depth	Inc	Azimuth	CrsLngth	TVD	North	East	Section	Dogleg	BldRate	Trnrate	Toolface
	Feet	Degrees	Degrees	Feet	Feet	Feet	Feet	Feet	/100f	/100f	/100f	Degrees
0	0.00	0.00	0.00	0.00	0.00	0.00	0.00	0.00	0.00	0.00	0.00	0.00
1	131.00	0.00	150.60	131.00	131.00	0.00	0.00	0.00	0.00	0.00	0.00	150.60
2	223.00	0.20	174.50	92.00	223.00	-0.16	0.02	-0.03	0.22	0.22	0.00	174.50
3	315.00	0.10	181.20	92.00	315.00	-0.40	0.03	-0.06	0.11	0.11	7.28	173.39
4	407.00	0.30	154.70	92.00	407.00	-0.70	0.13	-0.18	0.23	0.22	28.80	-38.47
5	499.00	0.40	133.20	92.00	499.00	-1.14	0.47	-0.54	0.18	0.11	23.37	-63.79
6	592.00	0.60	145.70	93.00	591.99	-1.76	0.98	-1.09	0.24	0.22	13.44	34.95
7	684.00	0.90	187.20	92.00	683.99	-2.87	1.16	-1.34	0.65	0.33	45.11	82.92
8	708.00	1.00	189.10	24.00	707.98	-3.27	1.10	-1.31	0.44	0.42	7.92	18.44
9	827.00	0.40	112.00	119.00	826.98	-4.45	1.32	-1.61	0.83	0.50	64.79	-156.82
10	923.00	0.20	156.80	96.00	922.97	-4.73	1.70	-2.01	0.31	0.21	46.67	151.36
11	1015.00	0.10	322.50	92.00	1014.97	-4.81	1.71	-2.03	0.32	0.11	180.11	175.24
12	1107.00	0.10	173.70	92.00	1106.97	-4.83	1.67	-1.99	0.21	0.00	161.74	-164.40
13	1199.00	0.60	98.20	92.00	1198.97	-4.98	2.16	-2.48	0.63	0.54	82.07	-85.06
14	1291.00	0.20	311.30	92.00	1290.97	-4.94	2.52	-2.83	0.84	0.43	159.67	-171.90
15	1384.00	0.40	276.70	93.00	1383.97	-4.80	2.07	-2.38	0.28	0.22	37.20	-60.36
16	1476.00	1.50	52.50	92.00	1475.96	-4.02	2.71	-2.97	1.97	1.20	147.61	144.67



Comment
DIP = 66.1
TD SURFACE
DIP = 67.05



#	Depth	Inc	Azimuth	CrsLngth	TVD	North	East	Section	Dogleg	BldRate	Trnrate	Toolface
17	1568.00	3.20	33.70	92.00	1567.88	-1.16	5.09	-5.15	2.00	1.85	20.43	-33.98
18	1660.00	4.30	44.30	92.00	1659.68	3.45	8.92	-8.68	1.41	1.20	11.52	37.58
19	1752.00	4.30	56.90	92.00	1751.43	7.80	14.22	-13.68	1.02	0.00	13.70	96.28
20	1844.00	5.50	55.50	92.00	1843.09	12.18	20.74	-19.90	1.31	1.30	1.52	-6.39
21	1937.00	5.80	50.60	93.00	1935.64	17.69	28.05	-26.83	0.61	0.32	5.27	-60.58
22	2029.00	5.30	54.70	92.00	2027.21	23.10	35.11	-33.52	0.69	0.54	4.46	143.61
23	2121.00	6.20	64.80	92.00	2118.74	27.67	43.07	-41.17	1.47	0.98	10.98	53.45
24	2213.00	5.50	51.50	92.00	2210.27	32.53	51.02	-48.78	1.65	0.76	14.46	-123.82
25	2305.00	6.50	55.20	92.00	2301.76	38.24	58.74	-56.12	1.16	1.09	4.02	22.99
26	2401.00	8.30	52.90	96.00	2396.96	45.52	68.73	-65.61	1.90	1.88	2.40	-10.49
27	2496.00	7.00	46.60	95.00	2491.12	53.64	78.41	-74.73	1.63	1.37	6.63	-150.27
28	2591.00	7.30	49.70	95.00	2585.38	61.52	87.22	-83.01	0.51	0.32	3.26	53.68
29	2687.00	9.60	52.50	96.00	2680.33	70.34	98.22	-93.41	2.43	2.40	2.92	11.53
30	2782.00	9.10	50.30	95.00	2774.07	79.96	110.29	-104.82	0.65	0.53	2.32	-145.52
31	2877.00	9.10	55.70	95.00	2867.87	88.99	122.27	-116.19	0.90	0.00	5.68	92.67
32	2973.00	9.70	62.00	96.00	2962.59	97.07	135.69	-129.05	1.24	0.63	6.56	62.89
33	3068.00	9.60	58.20	95.00	3056.24	105.00	149.48	-142.30	0.68	0.11	4.00	-100.79
34	3163.00	8.00	51.00	95.00	3150.12	113.33	161.36	-153.60	2.04	1.68	7.58	-148.98
35	3258.00	8.50	58.20	95.00	3244.14	121.20	172.46	-164.16	1.21	0.53	7.58	67.77
36	3354.00	7.70	60.80	96.00	3339.18	128.07	184.10	-175.33	0.92	0.83	2.71	156.68
37	3449.00	6.20	58.70	95.00	3433.48	133.84	194.04	-184.88	1.60	1.58	2.21	-171.43
38	3544.00	6.20	59.00	95.00	3527.93	139.15	202.82	-193.29	0.03	0.00	0.32	90.15
39	3639.00	7.60	60.30	95.00	3622.24	144.90	212.68	-202.75	1.48	1.47	1.37	7.01
40	3735.00	7.30	55.40	96.00	3717.43	151.51	223.21	-212.83	0.73	0.31	5.10	-117.69
41	3830.00	7.30	58.30	95.00	3811.66	158.11	233.32	-222.48	0.39	0.00	3.05	91.44
42	3925.00	7.20	53.40	95.00	3905.90	164.83	243.23	-231.93	0.66	0.11	5.16	-101.61
43	4020.00	7.60	46.90	95.00	4000.11	172.68	252.60	-240.76	0.98	0.42	6.84	-67.71
44	4115.00	7.60	58.00	95.00	4094.28	180.30	262.51	-250.16	1.54	0.00	11.68	95.50
45	4211.00	7.70	56.10	96.00	4189.43	187.25	273.24	-260.40	0.28	0.10	1.98	-69.37
46	4306.00	6.90	54.50	95.00	4283.66	194.11	283.16	-269.86	0.87	0.84	1.68	-166.53
47	4401.00	8.00	54.30	95.00	4377.85	201.28	293.18	-279.39	1.16	1.16	0.21	-1.45
48	4496.00	7.80	54.80	95.00	4471.95	208.86	303.82	-289.50	0.22	0.21	0.53	161.28



Comment



#	Depth	Inc	Azimuth	CrsLngth	TVD	North	East	Section	Dogleg	BldRate	Trnrate	Toolface
49	4592.00	7.30	53.90	96.00	4567.12	216.21	314.07	-299.25	0.54	0.52	0.94	-167.14
50	4687.00	6.00	56.90	95.00	4661.48	222.47	323.10	-307.86	1.42	1.37	3.16	166.52
51	4782.00	6.50	52.70	95.00	4755.91	228.44	331.54	-315.89	0.71	0.53	4.42	-44.54
52	4878.00	6.90	57.50	96.00	4851.26	234.83	340.73	-324.64	0.72	0.42	5.00	56.86
53	4973.00	7.60	58.00	95.00	4945.50	241.23	350.87	-334.34	0.74	0.74	0.53	5.40
54	5068.00	6.90	54.30	95.00	5039.74	247.89	360.83	-343.84	0.89	0.74	3.89	-148.12
55	5163.00	6.20	52.70	95.00	5134.12	254.33	369.54	-352.12	0.76	0.74	1.68	-166.18
56	5259.00	5.50	49.20	96.00	5229.62	260.48	377.15	-359.31	0.82	0.73	3.65	-154.73
57	5354.00	4.70	51.10	95.00	5324.24	265.89	383.62	-365.41	0.86	0.84	2.00	169.02
58	5449.00	3.10	62.90	95.00	5419.02	269.51	388.94	-370.48	1.88	1.68	12.42	159.17
59	5545.00	1.40	33.40	96.00	5514.94	271.67	391.90	-373.29	2.09	1.77	30.73	-159.87
60	5640.00	1.50	72.10	95.00	5609.92	273.02	393.72	-375.02	1.02	0.11	40.74	103.74
61	5735.00	1.70	71.50	95.00	5704.88	273.85	396.24	-377.48	0.21	0.21	0.63	-5.09
62	5830.00	1.60	56.40	95.00	5799.84	275.03	398.68	-379.84	0.47	0.11	15.89	-110.43
63	5925.00	1.70	63.80	95.00	5894.80	276.39	401.05	-382.11	0.25	0.11	7.79	68.59
64	6020.00	0.60	41.80	95.00	5989.78	277.38	402.65	-383.64	1.23	1.16	23.16	-168.88
65	6116.00	1.10	188.10	96.00	6085.78	276.84	402.85	-383.88	1.70	0.52	152.40	158.06
66	6211.00	1.10	175.40	95.00	6180.76	275.03	402.80	-383.94	0.26	0.00	13.37	-96.35
67	6306.00	1.10	157.70	95.00	6275.74	273.28	403.21	-384.48	0.36	0.00	18.63	-98.85
68	6401.00	0.60	206.90	95.00	6370.73	271.99	403.34	-384.68	0.89	0.53	51.79	147.32
69	6497.00	0.80	200.70	96.00	6466.72	270.92	402.87	-384.29	0.22	0.21	6.46	-23.86
70	6592.00	1.20	218.00	95.00	6561.71	269.51	402.02	-383.54	0.52	0.42	18.21	45.91
71	6640.00	5.10	270.00	48.00	6609.63	269.12	399.58	-381.12	9.30	8.13	108.33	64.20
72	6687.00	9.10	280.40	47.00	6656.27	269.79	393.83	-375.34	8.91	8.51	22.13	23.03
73	6735.00	13.70	288.10	48.00	6703.31	272.24	384.69	-366.06	10.07	9.58	16.04	22.12
74	6782.00	18.60	290.50	47.00	6748.44	276.60	372.37	-353.48	10.52	10.43	5.11	8.92
75	6830.00	23.50	289.10	48.00	6793.22	282.41	356.15	-336.92	10.26	10.21	2.92	-6.52
76	6877.00	28.80	285.80	47.00	6835.40	288.57	336.39	-316.79	11.69	11.28	7.02	-16.84
77	6925.00	34.00	280.20	48.00	6876.37	294.10	312.03	-292.13	12.41	10.83	11.67	-31.72
78	6972.00	38.30	278.40	47.00	6914.31	298.55	284.67	-264.54	9.42	9.15	3.83	-14.60
79	7020.00	42.60	276.10	48.00	6950.83	302.45	253.79	-233.47	9.48	8.96	4.79	-20.02
80	7068.00	47.70	273.30	48.00	6984.67	305.20	219.89	-199.46	11.40	10.63	5.83	-22.27



Comment



#	Depth	Inc	Azimuth	CrsLngth	TVD	North	East	Section	Dogleg	BldRate	Trnrate	Toolface
81	7163.00	62.20	270.90	95.00	7039.09	307.90	142.38	-121.94	15.40	15.26	2.53	-8.43
82	7258.00	78.10	268.20	95.00	7071.25	307.10	53.33	-33.13	16.95	16.74	2.84	-9.57
83	7305.00	84.80	263.30	47.00	7078.24	303.64	7.02	12.86	17.59	14.26	10.43	-36.27
84	7373.00	90.60	265.40	68.00	7080.97	296.95	-60.56	79.86	9.07	8.53	3.09	19.94
85	7468.00	90.80	264.90	95.00	7079.81	288.92	-155.22	173.78	0.57	0.21	0.53	-68.19
86	7562.00	92.50	266.80	94.00	7077.10	282.12	-248.92	266.84	2.71	1.81	2.02	48.14
87	7657.00	91.60	268.20	95.00	7073.70	277.98	-343.77	361.21	1.75	0.95	1.47	122.73
88	7751.00	91.20	269.80	94.00	7071.40	276.34	-437.72	454.86	1.75	0.43	1.70	104.02
89	7845.00	88.90	270.50	94.00	7071.32	276.59	-531.72	548.67	2.56	2.45	0.74	163.07
90	7940.00	89.60	271.40	95.00	7072.57	278.16	-626.69	643.54	1.20	0.74	0.95	52.13
91	8034.00	89.50	271.40	94.00	7073.30	280.46	-720.66	737.46	0.11	0.11	0.00	180.00
92	8129.00	89.50	270.10	95.00	7074.13	281.70	-815.65	832.33	1.37	0.00	1.37	-90.01
93	8223.00	92.20	272.20	94.00	7072.74	283.59	-909.61	926.21	3.64	2.87	2.23	37.86
94	8317.00	90.00	271.90	94.00	7070.93	286.95	-1003.52	1020.14	2.36	2.34	0.32	-172.23
95	8412.00	89.40	271.40	95.00	7071.43	289.69	-1098.48	1115.08	0.82	0.63	0.53	-140.20
96	8506.00	88.60	271.70	94.00	7073.07	292.23	-1192.43	1208.99	0.91	0.85	0.32	159.45
97	8600.00	89.60	270.50	94.00	7074.55	294.03	-1286.40	1302.88	1.66	1.06	1.28	-50.20
98	8695.00	91.50	269.60	95.00	7073.64	294.12	-1381.39	1397.67	2.21	2.00	0.95	-25.34
99	8789.00	91.40	269.60	94.00	7071.26	293.46	-1475.36	1491.39	0.11	0.11	0.00	180.00
100	8883.00	91.30	272.40	94.00	7069.04	295.10	-1569.31	1585.25	2.98	0.11	2.98	92.01
101	8978.00	91.10	272.10	95.00	7067.05	298.83	-1664.21	1680.19	0.38	0.21	0.32	-123.69
102	9072.00	90.60	271.00	94.00	7065.66	301.37	-1758.17	1774.11	1.29	0.53	1.17	-114.44
103	9167.00	90.80	271.50	95.00	7064.50	303.44	-1853.14	1869.02	0.57	0.21	0.53	68.19
104	9261.00	91.20	271.00	94.00	7062.86	305.49	-1947.10	1962.91	0.68	0.43	0.53	-51.33
105	9355.00	88.70	270.70	94.00	7062.94	306.89	-2041.08	2056.78	2.68	2.66	0.32	-173.16
106	9450.00	89.40	269.10	95.00	7064.52	306.72	-2136.06	2151.55	1.84	0.74	1.68	-66.38
107	9544.00	89.40	267.70	94.00	7065.50	304.10	-2230.02	2245.13	1.49	0.00	1.49	-90.01
108	9639.00	91.90	268.20	95.00	7064.42	300.70	-2324.95	2339.63	2.68	2.63	0.53	11.31
109	9733.00	91.10	268.20	94.00	7061.96	297.75	-2418.87	2433.16	0.85	0.85	0.00	180.00
110	9828.00	90.00	269.20	95.00	7061.05	295.59	-2513.83	2527.79	1.56	1.16	1.05	137.72
111	9922.00	89.60	268.70	94.00	7061.38	293.87	-2607.82	2621.45	0.68	0.43	0.53	-128.66
112	10017.00	89.00	268.50	95.00	7062.54	291.55	-2702.78	2716.06	0.67	0.63	0.21	-161.57



Comment



#	Depth	Inc	Azimuth	CrsLngth	TVD	North	East	Section	Dogleg	BldRate	Trnrate	Toolface
113	10111.00	88.40	270.00	94.00	7064.67	290.32	-2796.75	2809.75	1.72	0.64	1.60	111.82
114	10206.00	90.70	270.10	95.00	7065.42	290.40	-2891.74	2904.54	2.42	2.42	0.11	2.49
115	10300.00	90.50	268.70	94.00	7064.43	289.42	-2985.72	2998.26	1.50	0.21	1.49	-98.12
116	10395.00	91.80	268.70	95.00	7062.53	287.26	-3080.68	3092.87	1.37	1.37	0.00	0.00
117	10489.00	92.40	270.10	94.00	7059.08	286.28	-3174.61	3186.53	1.62	0.64	1.49	66.76
118	10583.00	92.20	270.00	94.00	7055.31	286.36	-3268.53	3280.26	0.24	0.21	0.11	-153.45
119	10678.00	91.90	272.60	95.00	7051.91	288.51	-3363.44	3375.11	2.75	0.32	2.74	96.54
120	10772.00	91.90	272.90	94.00	7048.79	293.02	-3457.28	3469.04	0.32	0.00	0.32	90.00
121	10867.00	92.30	273.80	95.00	7045.31	298.57	-3552.05	3563.97	1.04	0.42	0.95	66.01
122	10961.00	89.30	272.20	94.00	7044.00	303.49	-3645.90	3657.94	3.62	3.19	1.70	-151.91
123	11056.00	85.60	269.40	95.00	7048.23	304.82	-3740.77	3752.70	4.88	3.89	2.95	-142.96
124	11150.00	88.40	264.90	94.00	7053.15	300.14	-3834.49	3845.91	5.63	2.98	4.79	-58.21
125	11244.00	92.20	264.20	94.00	7052.66	291.22	-3928.05	3938.68	4.11	4.04	0.74	-10.44
126	11339.00	93.80	268.20	95.00	7047.68	284.93	-4022.69	4032.71	4.53	1.68	4.21	68.08
127	11433.00	92.10	270.50	94.00	7042.84	283.87	-4116.55	4126.30	3.04	1.81	2.45	126.44
128	11527.00	90.00	272.10	94.00	7041.12	286.00	-4210.50	4220.19	2.81	2.23	1.70	142.68
129	11622.00	90.00	270.80	95.00	7041.12	288.40	-4305.47	4315.11	1.37	0.00	1.37	-90.00
130	11650.00	90.30	271.00	28.00	7041.05	288.84	-4333.46	4343.07	1.29	1.07	0.71	33.69
131	11705.00	90.30	271.00	55.00	7040.76	289.80	-4388.45	4398.01	0.00	0.00	0.00	0.00

Closure is 4398.0113 feet on an Azimuth of 273.7782



Comment

TD BIT PRJ