







Lat40, Inc. 6250 W. 10th Street, Unit 2, Greeley, CO 970-515-5294

SITE SKETCH

TRIMAR FARMS 29Y-201

SECTION: 29
TOWNSHIP: 5N
RANGE: 63W

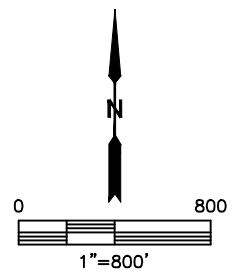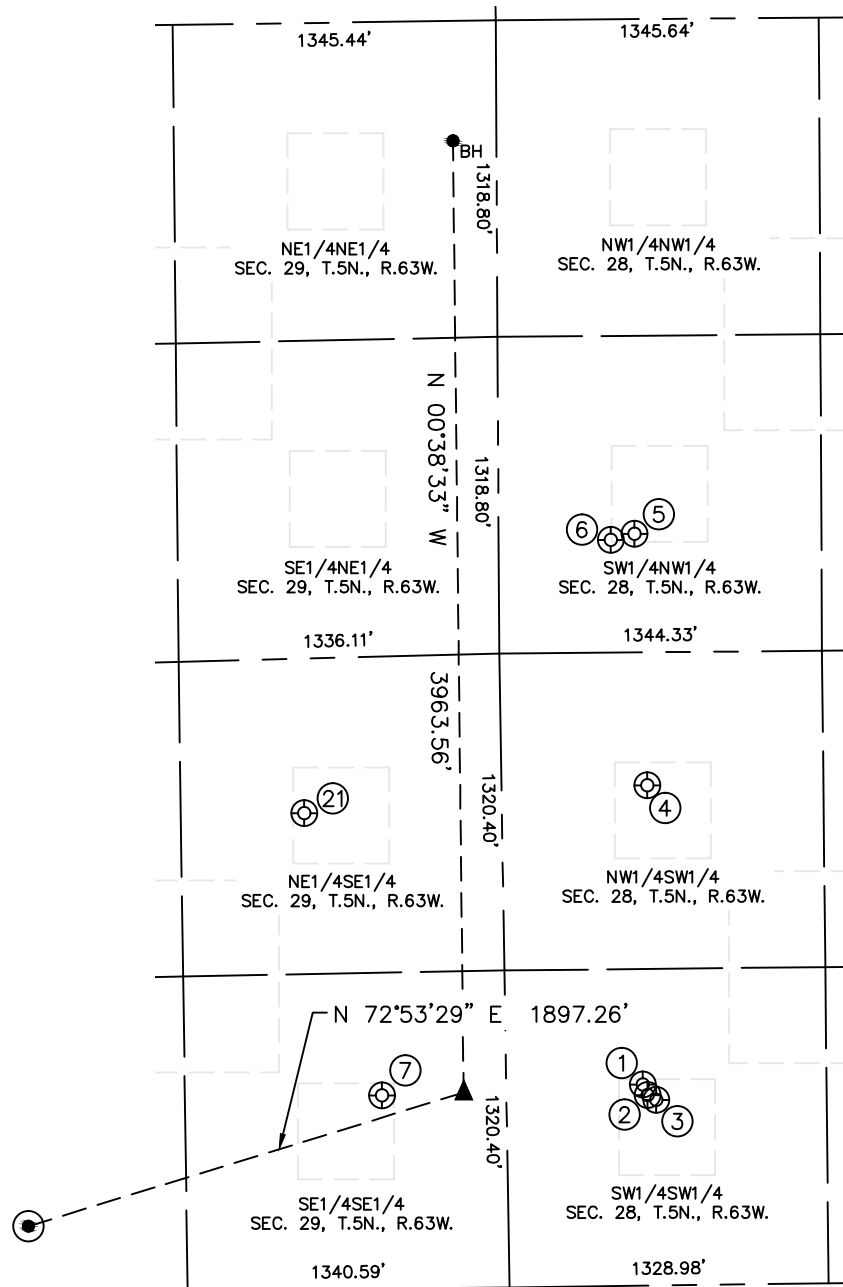

WELL NO.	WELL NAME	SHL FOOTAGE				SHL LAT°	SHL LONG°	PDOP	ELEV (FT.)	1/4/1/4
1	PETERSON 14-28	837	FSL	569	FWL	40.36556	-104.44843	1.6	4551	SWSW
2	NORTH PLATTE J-F-28HZ	793	FSL	587	FWL	40.36544	-104.44836	1.6	4551	SWSW
3	NORTH PLATTE E-A-28HC	773	FSL	623	FWL	40.36539	-104.44823	1.6	4551	SWSW
4	DOW 13-28	2084	FSL	607	FWL	40.36898	-104.44831	1.7	4541	NWSW
5	DOW 12-28	2144	FNL	565	FWL	40.37186	-104.44846	1.9	4541	SWNW
6	DOW 1-29	2169	FNL	467	FWL	40.37179	-104.44881	1.7	4541	SWNW
7	MORGANTE 44-29U	805	FSL	518	FEL	40.36548	-104.45233	1.8	4558	SESE
21	VIEFHAUS 43-29U	1984	FSL	823	FEL	40.36871	-104.45344	1.7	4553	NESE

DATE: 2/9/2015
PROJECT#: 2014131