



May 6, 2015

Mr. Matt Lepore, Director
Colorado Oil and Gas Conservation Commission
The Chancery Building
1120 Lincoln Street, Suite 801
Denver, CO 80203

RE: Will 6-62-15-0164C2B
Township 6 North, Range 62 West, 6th P.M.
Section 15: NWNW (surface location)
Weld County, Colorado

Proposed Wellbore Unit (640 acres):

Township 6 North, Range 62 West, 6th P.M.
Section 15-W2W2
Section 16-E2E2
Section 21-E2E2
Section 22-W2W2

Dear Mr. Lepore:

Bill Barrett Corporation ("BBC") is planning to drill the captioned boundary well in accordance with the provisions of COGCC 318A.e.

BBC's wellbore spacing unit consists of section 15: W/2W/2, section 16: E/2E/2, section 21: E/2E/2, section 22: W/2W/2, creating the above referenced spacing unit in which we will target the Niobrara formation. I certify that all of the owners within the proposed wellbore spacing unit were noticed and no objections were received.

Enclosed is a copy of the following document to assist you in your review and approval of BBC's proposed changes for the captioned well.

- Plat illustrating the proposed wellbore spacing unit on existing location plat

Thank you for your attention to the enclosed. BBC respectfully requests that the COGCC review the enclosed information and approve the proposed changes for the captioned well.

Sincerely,

A handwritten signature in blue ink, appearing to read 'Mary Pobuda', is written over a faint, larger signature.


Mary Pobuda
Permit Analyst

1099 18th Street, Suite 2300
Denver, CO 80202
P 303.293.9100
F 303.291.0420

LEGEND:

- └─┘ = 90° SYMBOL
- = PROPOSED WELLHEAD.
- ◆ = LANDING POINT.
- = TARGET BOTTOM HOLE.
- ▲ = SECTION CORNERS LOCATED.

T6N, R62W, 6th P.M.

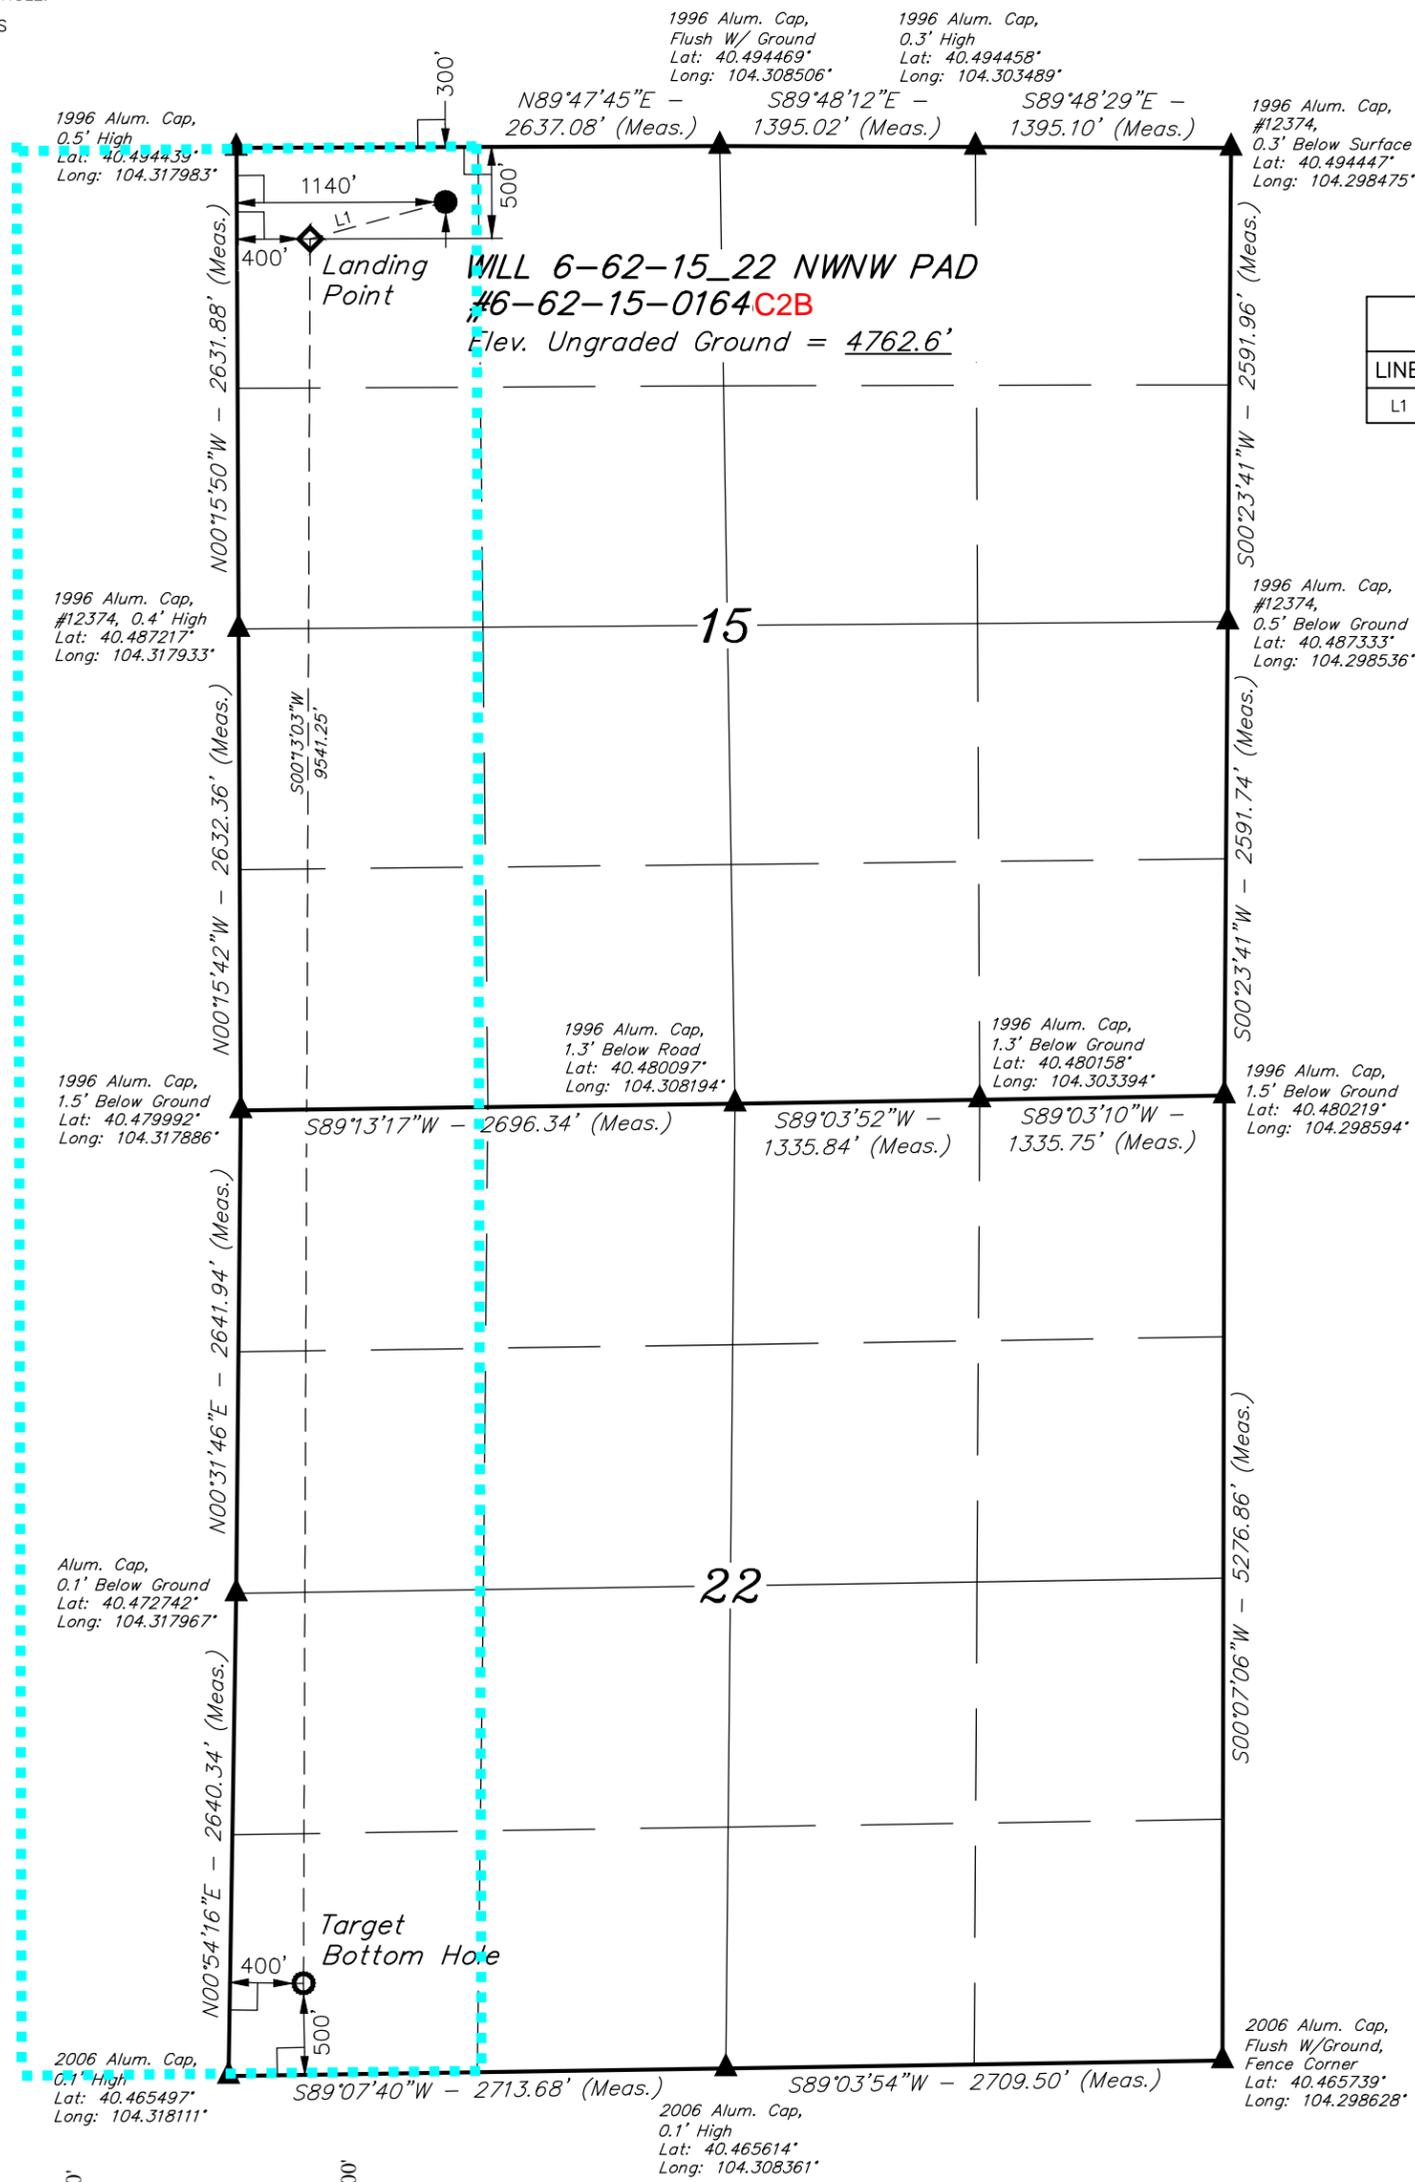

NAD 83 (TARGET BOTTOM HOLE) LATITUDE = 40°28'00.79" (40.466886) LONGITUDE = 104°18'59.92" (104.316644)	NAD 83 (LANDING POINT) LATITUDE = 40°29'35.05" (40.493069) LONGITUDE = 104°18'59.53" (104.316536)	NAD 83 (SURFACE LOCATION) LATITUDE = 40°29'37.06" (40.493628) LONGITUDE = 104°18'49.97" (104.313881)
NAD 27 (TARGET BOTTOM HOLE) LATITUDE = 40°28'00.86" (40.466906) LONGITUDE = 104°18'58.10" (104.316139)	NAD 27 (LANDING POINT) LATITUDE = 40°29'35.12" (40.493089) LONGITUDE = 104°18'57.71" (104.316031)	NAD 27 (SURFACE LOCATION) LATITUDE = 40°29'37.12" (40.493644) LONGITUDE = 104°18'48.14" (104.313372)
STATE PLANE NAD 83 (COLORADO NORTH) N: 1415124.24 E: 3329241.62	STATE PLANE NAD 83 (COLORADO NORTH) N: 1424662.56 E: 3329144.59	STATE PLANE NAD 83 (COLORADO NORTH) N: 1424875.39 E: 3329880.65
STATE PLANE NAD 27 (COLORADO NORTH) N: 415125.21 E: 2329391.31	STATE PLANE NAD 27 (COLORADO NORTH) N: 424663.29 E: 2329294.19	STATE PLANE NAD 27 (COLORADO NORTH) N: 424876.10 E: 2330030.25

CERTIFICATE

THIS IS TO CERTIFY THAT THE ABOVE PLAT WAS PREPARED FROM FIELD NOTES OF ACTUAL SURVEYS MADE BY ME OR UNDER MY SUPERVISION AND THAT THE SAME ARE TRUE AND CORRECT TO THE BEST OF MY KNOWLEDGE AND BELIEF.



BASIS OF BEARINGS
BASIS OF BEARINGS IS A G.P.S. OBSERVATION

BASIS OF ELEVATION

SPOT ELEVATION LOCATED AT THE NORTHEAST CORNER OF SECTION 24, T5N, R62W, 6th P.M. TAKEN FROM THE POINT OF ROCKS, QUADRANGLE, COLORADO, WELD COUNTY, 7.5 MINUTE QUAD (TOPOGRAPHIC MAP) PUBLISHED BY THE UNITED STATES DEPARTMENT OF THE INTERIOR, GEOLOGICAL SURVEY. SAID ELEVATION IS MARKED AS BEING 4530 FEET.



BILL BARRETT CORPORATION

WILL 6-62-15_22 NWNW PAD #6-62-15-0164C2B
 NW 1/4 NW 1/4, SECTION 15, T6N, R62W, 6th P.M.
 WELD COUNTY, COLORADO

SURVEYED BY: GREG WEIMER, C.J.	DATE: 04-25-14
DRAWN BY: J.S.	DATE DRAWN: 05-08-14
SCALE: 1" = 1000'	REVISION: 03-16-15 K.B.

WELL LOCATION PLAT



UELS, LLC
 Corporate Office * 85 South 200 East
 Vernal, UT 84078 * (435) 789-1017