


Current

Owner: Magpie Operating Well Name: Proctor Skaer 1A
County: Larimer Field: Loveland Pool:
Coordinates: Sec: 31 Twp: 5N Rn: 68W

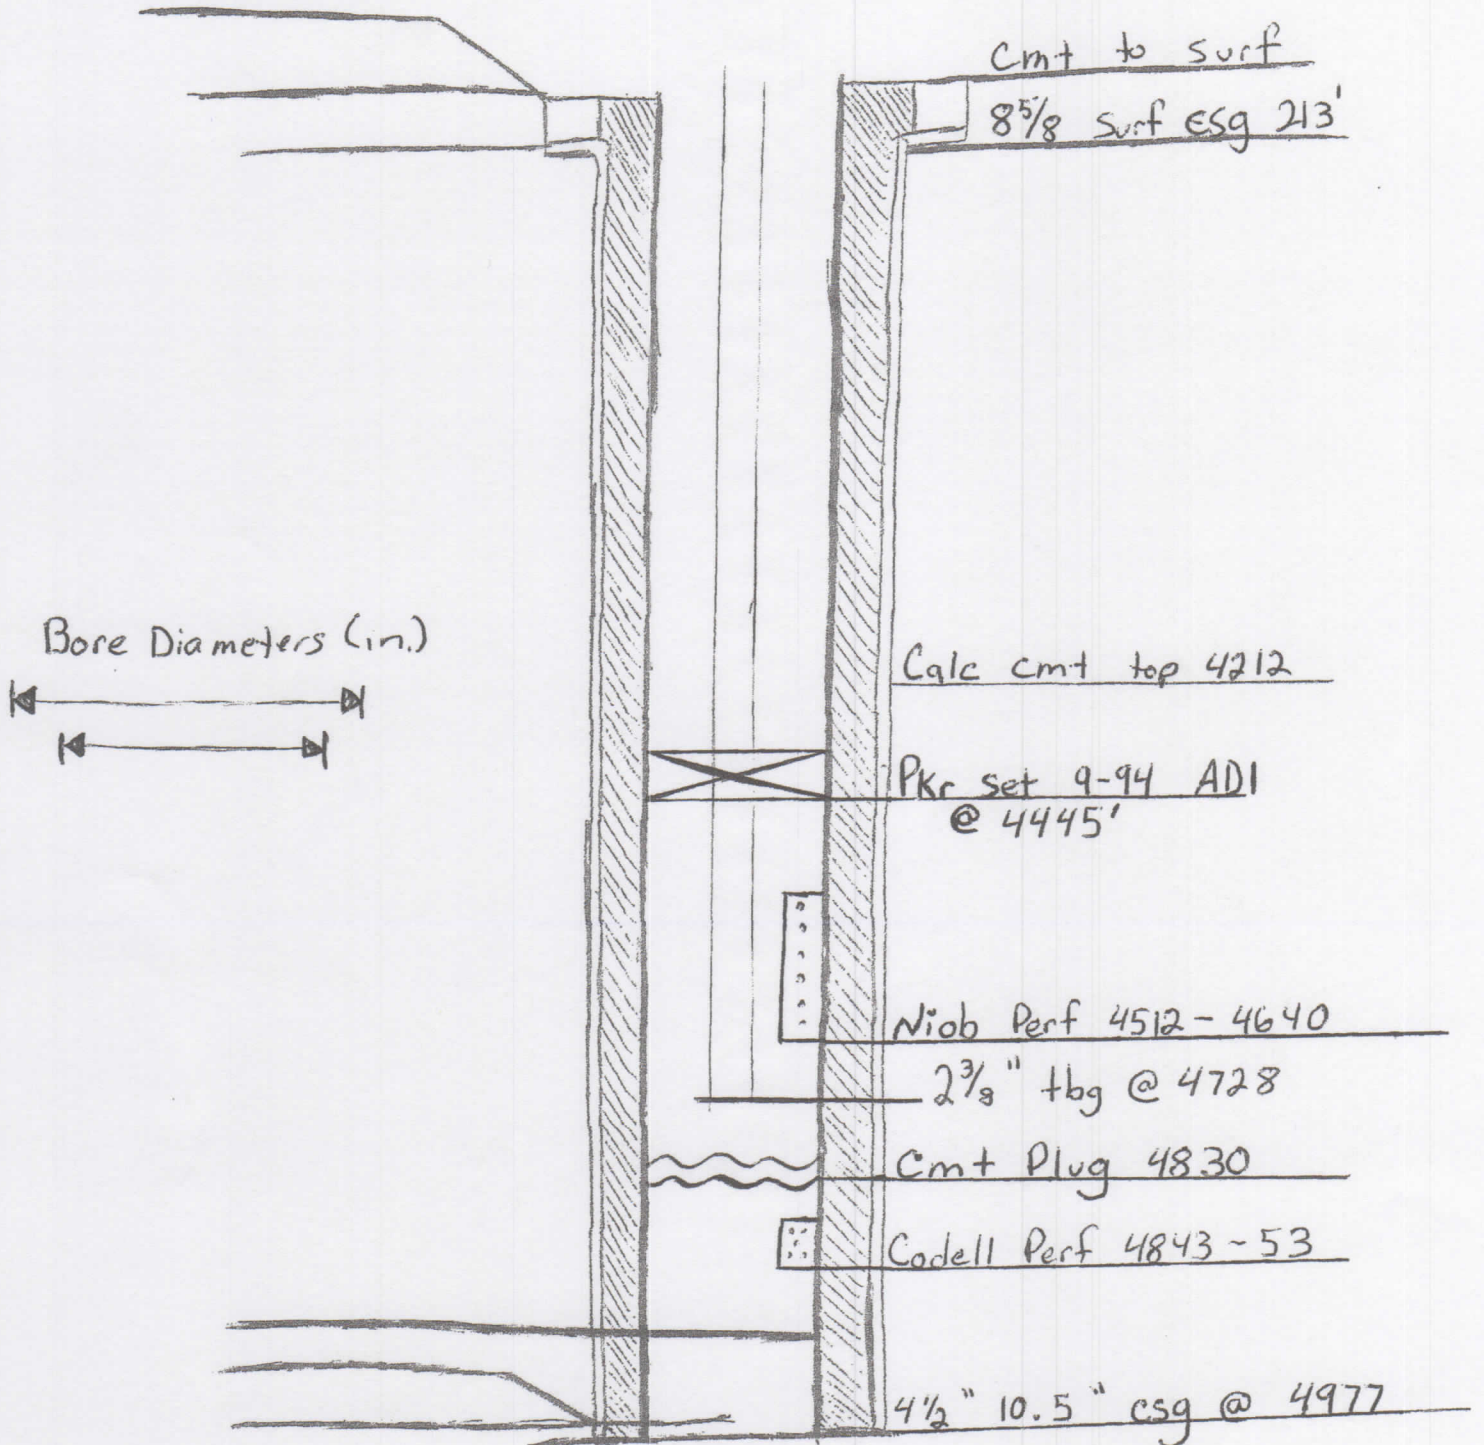

Proposed

Owner: Magpie Operating Inc Well Name: Proctor Skaer 1A
County: Larimer Field: Loveland Pool:
Coordinates: Sec: 31 Twp: 5N Rn 68W

