


Well Name: MOTIS 01 API 10878

VERTICAL - Original Hole, 5/11/2015 3:19:49 PM

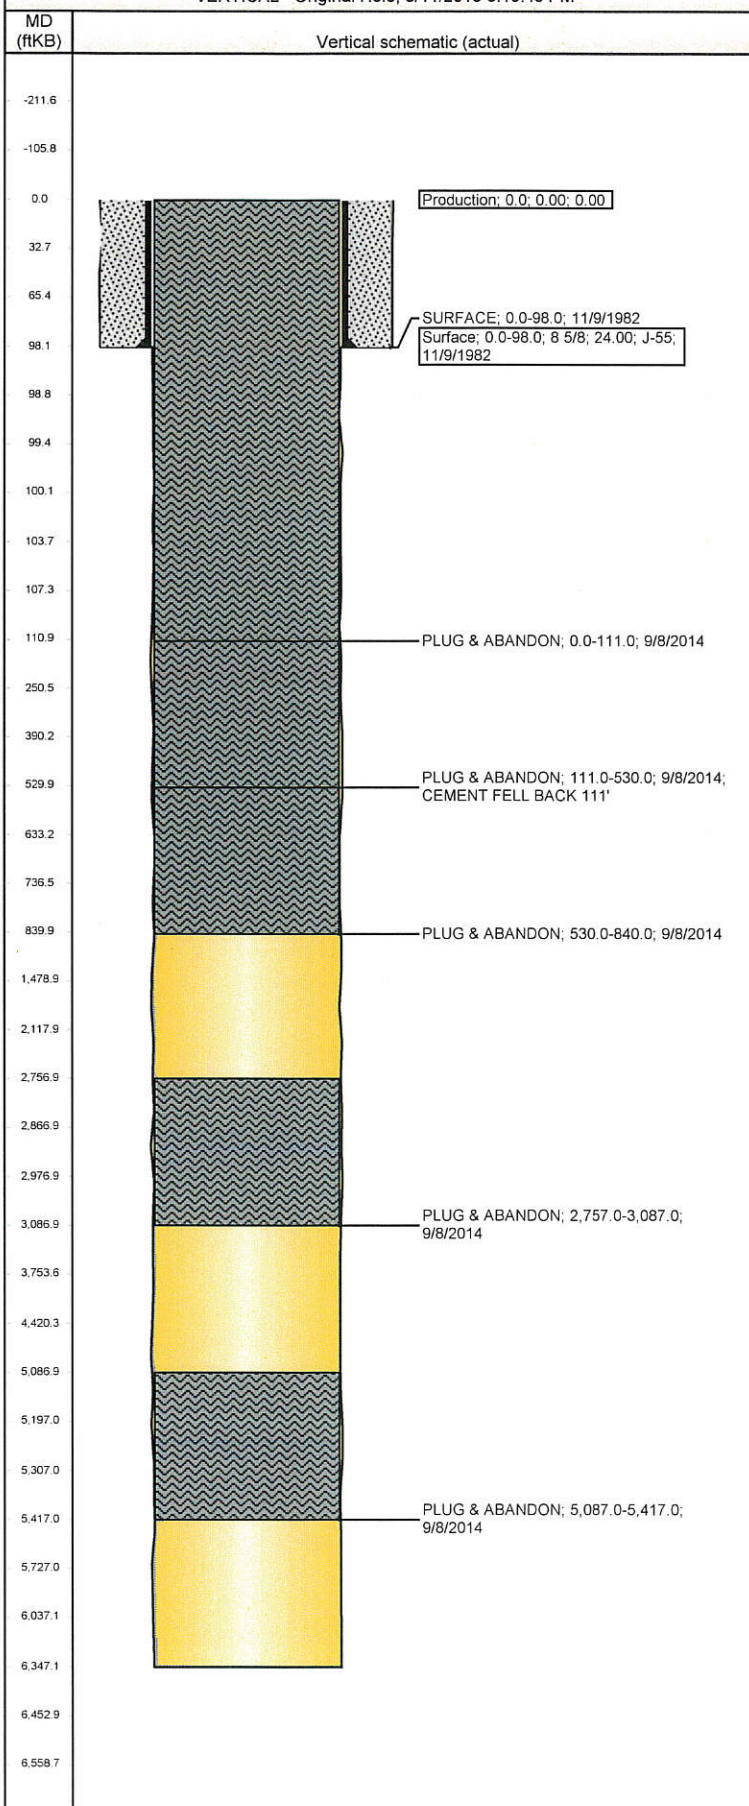

Well Header

API 05-123-10878	Business Unit DJ BASIN	District 15	Well Config VERTICAL
Original KB Elevation (ft)	KB - GL / MSL (ftKB)	Spud Date 11/9/1982	P & A Date
Comment			

Directions To Well

WCR 127 & WCR 116, EAST 3.0mi, SOUTH 2.9mi, WEST 0.2mi, SOUTHWEST 0.25mi Into

Current PBD (ftKB)

Bottom Hole Location

North-South Distance (ft)	From N or S Line	East-West Distance (ft)	From E or W Line
---------------------------	------------------	-------------------------	------------------

Plug Back Total Depths

Date	Depth (ftKB)	Method	Com

Wellbore Sections

Section Des	Size (in)	Act Top, MD (ftKB)	Act Btm, MD (ftKB)
SURFACE	12 1/4	0.0	98.0
PRODUCTION	7 7/8	98.0	6,347.0

Zone Statuses

Zone Name	Status Date	Status	Fluid Type	Job

Casing Strings

Csg Des	Run Date	OD (in)	Wt/Len (lb/ft)	Grade	Top, MD (ftKB)	MD (ftKB)
Production						
Surface	11/9/1982	8 5/8	24.00	J-55	0.0	98.0

Cement

Des	Top (ftKB)	Btm (ftKB)
SURFACE	0.0	98.0
PLUG & ABANDON	0.0	111.0
PLUG & ABANDON	111.0	530.0
PLUG & ABANDON	530.0	840.0
PLUG & ABANDON	2,757.0	3,087.0
PLUG & ABANDON	5,087.0	5,417.0

Tubing Components

Item Des	OD (in)	Wt (lb/ft)	Grade	Jts	Len (ft)

Perforation Data

Zone	Bnch/St g	Entered Shot Total	Top (ftKB)	Btm (ftKB)	Date

Other In Hole

Run Date	Des	OD (in)	Top (ftKB)	Btm (ftKB)

Logs

Date	Type	Top, MD (ftKB)	Btm, MD (ftKB)