

KERR-MCGEE OIL AND GAS ONSHORE LP

CAMP LEWIS C. "B" UNIT 1

SW SW 30 3N 65W 990' FSL 990' FWL

WELD,COLORADO

05/07/2015

AREA: E1

ROUTE: E13 Spud: 07/27/1973

WINS No.: H5702

AFE/WO#: 88609767

API#: 0512307745

GL: 4969

KB: 4979

MTD: 7998

TVD: 7998


LOG MD:

PBMD: 7951

PBTVD:

Directions:

RD 28 & RD 39, W 7/10, N 1/10 INTO

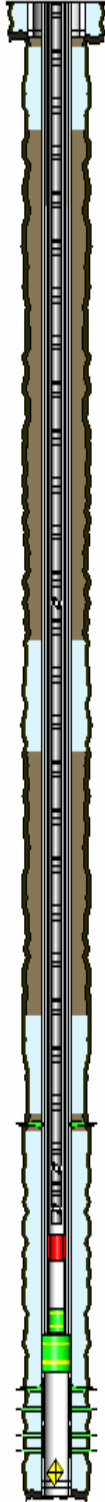

HOLE SECTIONS		Size	Top	Btm	TD Date			
SURFACE		12.25	10	232	07/27/1973			
PRODUCTION		7.88	232	7998	08/14/1973			
TUBULARS	Tool Type	Joints	Size	Weight	Grade	Thread	Top D	Bottom D
SURFACE CASING	Casing	5	8.62	24.00			10	230
	Casing	1	8.62				230	232
PRODUCTION CASING	Casing	192	4.50				10	7996
	Casing	1	4.50				7996	7997
	Casing	1	4.50				7997	7998
FISH	Lost Plug	1					7906	7911
SAND PLUG	Sand Plug	1	4.50				7785	7790
PRODUCTION LINER	Casing	239	2.88	6.50	N-80	8RD EUE	10	7432
	Pup Joint	1	2.88				7432	7443
	Casing	10	2.88	6.50	N-80	8RD EUE	7443	7763
	Latch Down Baffle	1	2.88				7763	7763
PRODUCTION TUBING	Tubing	223	1.66	2.40	J-55	10RD NUE	10	7349
	Tubing	1	1.66				7349	7350
	Tubing	1	1.66				7350	7351
CEMENT JOBS	Stage	Sacks	Cement Jobs			Top D	Btm D	cbl
SURFACE CASING	PRIM CMT 1ST STAGE	200	LEAD	CEMENT		10	232	No
PRODUCTION CASING	PRIM CMT 1ST STAGE	200	LEAD	CEMENT		7280	7998	Yes
PRODUCTION CASING	SQUEEZE JOB	175	LEAD	CEMENT		6572	7215	Yes
PRODUCTION CASING	SQUEEZE JOB	313	LEAD	CEMENT		4140	4860	Yes
PRODUCTION CASING	SQUEEZE JOB	150	LEAD	CEMENT		290	822	Yes
PRODUCTION LINER	PRIM LINER CEMENT	110	LEAD	CEMENT		1320	4200	Yes
	PRIM LINER CEMENT	110	TAIL	CEMENT		4200	7766	Yes
PERFORATIONS								
Formation	Zone	Top	Btm	Date	Reason	Comments		
		735	736	05/30/2006	CEMENT SQUEEZE			
SUSSEX		4200	4201	05/31/2006	CEMENT SQUEEZE			
SUSSEX		4860	4861	05/31/2006	CEMENT SQUEEZE			
NIOBRARA		7154	7164	12/30/1992	PRODUCTION	-- [WV Data Migration]		
NIOBRARA		7215	7216	11/30/1992	CEMENT SQUEEZE			
NIOBRARA		7227	7230	12/30/1992	PRODUCTION			
CODELL		7364	7374	12/02/1992	PRODUCTION	-- [WV Data Migration]		
CODELL		7365	7377	06/29/2006	PRODUCTION	-- [WV Data Migration]		
J SAND		7838	7874	10/11/1973	PRODUCTION	-- [WV Data Migration]		
J SAND		7850	7859	10/11/1973	PRODUCTION			
J SAND		7865	7874	10/11/1973	PRODUCTION			

KERR-MCGEE OIL AND GAS ONSHORE LP
CAMP LEWIS C. "B" UNIT 1
SW SW 30 3N 65W 990' FSL 990' FWL
WELD,COLORADO
05/07/2015

AREA: E1 ROUTE: E13 Spud: 07/27/1973 WINS No.: H5702 AFE/WO#: 88609767 API#: 0512307745

GL: 4969 KB: 4979 MTD: 7998 TVD: 7998 LOG MD: PBMD: 7951 PBTVD:

Directions: RD 28 & RD 39, W 7/10, N 1/10 INTO

Comments: