Frac Wellbore Schematic Report

noble energy

Well Name: SARCHET X20-02

VERTICAL - ORIGINAL HOLE, 5/11/2015 1:37:44 PM

Well Header

API	Business Unit	District	Well Config
05-123-14952	DJ BASIN	15	VERTICAL

MD (ftKB) | Vertical schematic (actual)

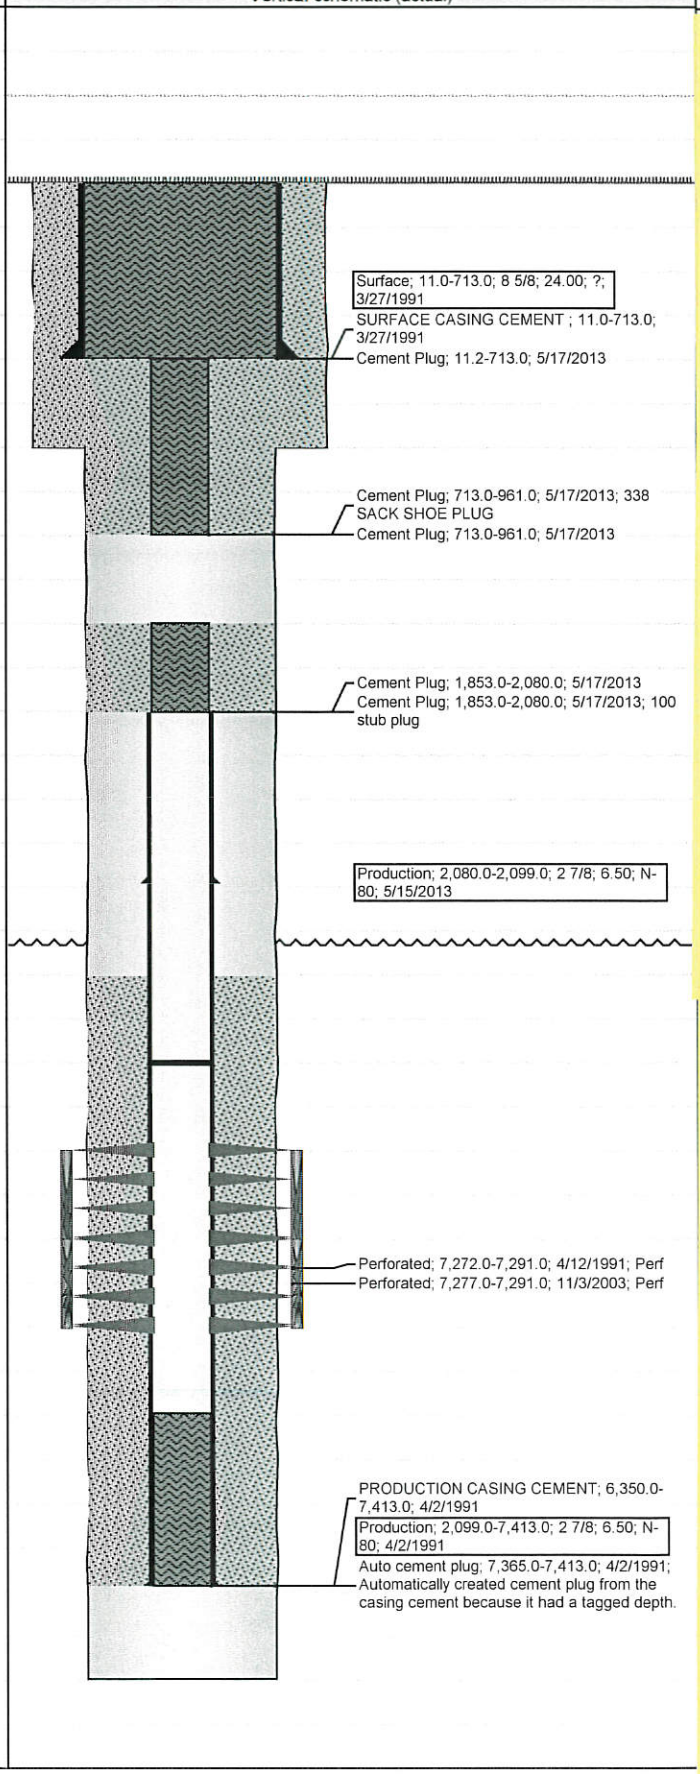

Report Printed: 5/11/2015