Frac Wellbore Schematic Report

noble energy

Well Name: DKW GREEN STATE BB18-07

VERTICAL - ORIGINAL HOLE, 5/20/2015 1:54:00 PM

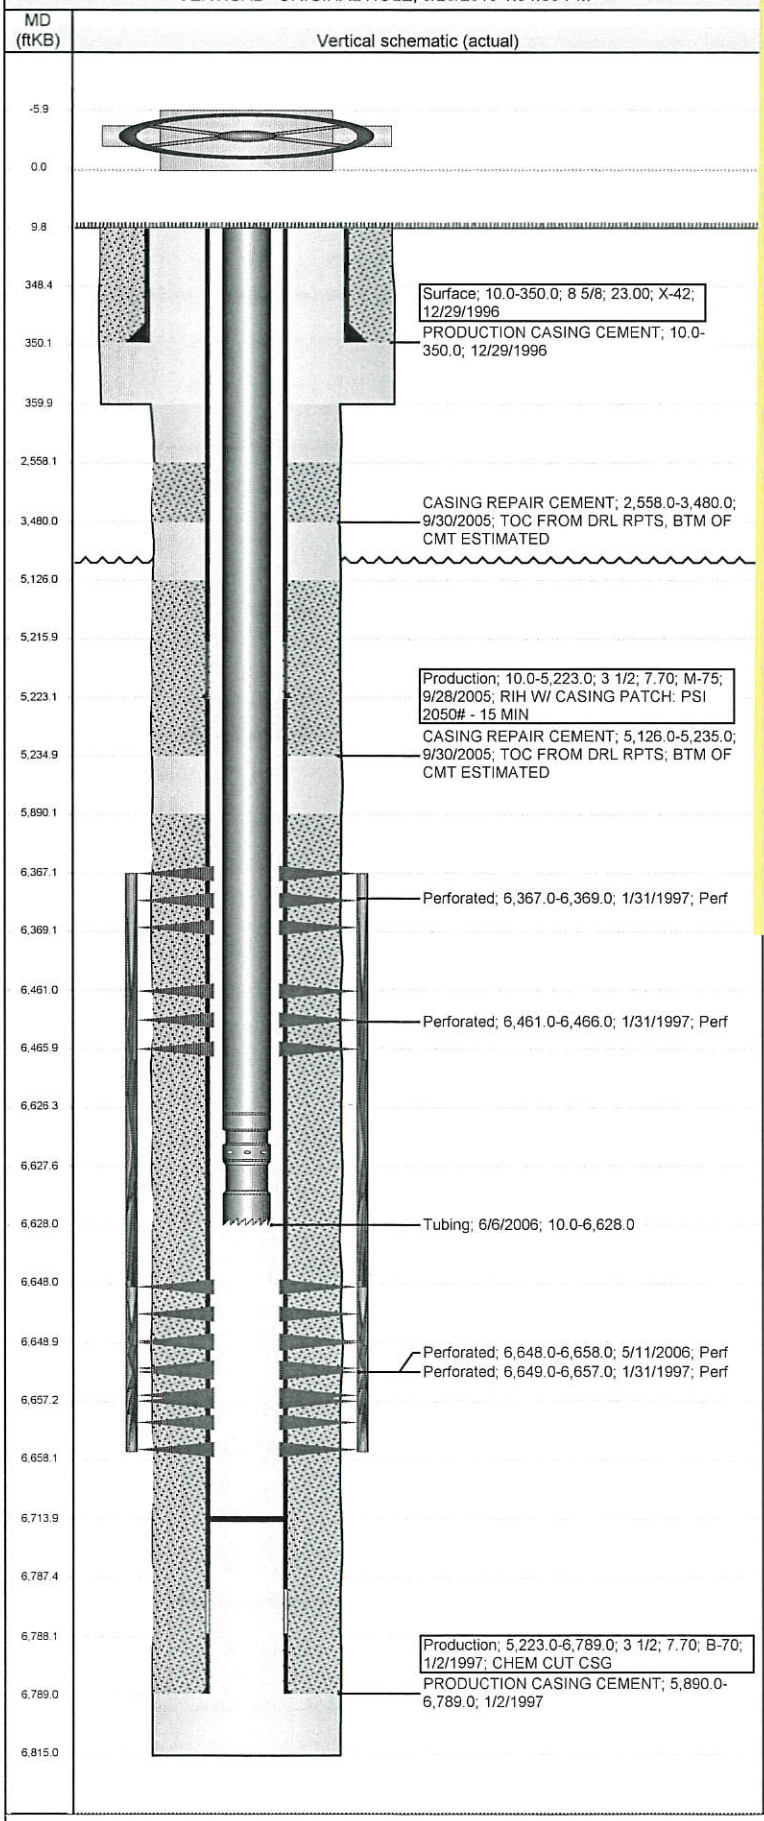

Report Printed: 5/20/2015