




05-005-00210
Loc# 320632

Lease: Lotigo
Well #: 39

Spud Date: 03/12/1979
KB: 0
TD: 6855

Plot Date: 08/31/2006
ELEV: 5495
PBTD: 6830

API #: 05-005-06215-00
Location: Sec 24 Twn 5S Rng 61W
County: Arapahoe
State: Colorado
Field: Lotigo Storage Field
Operator: Colorado Interstate Gas Co.

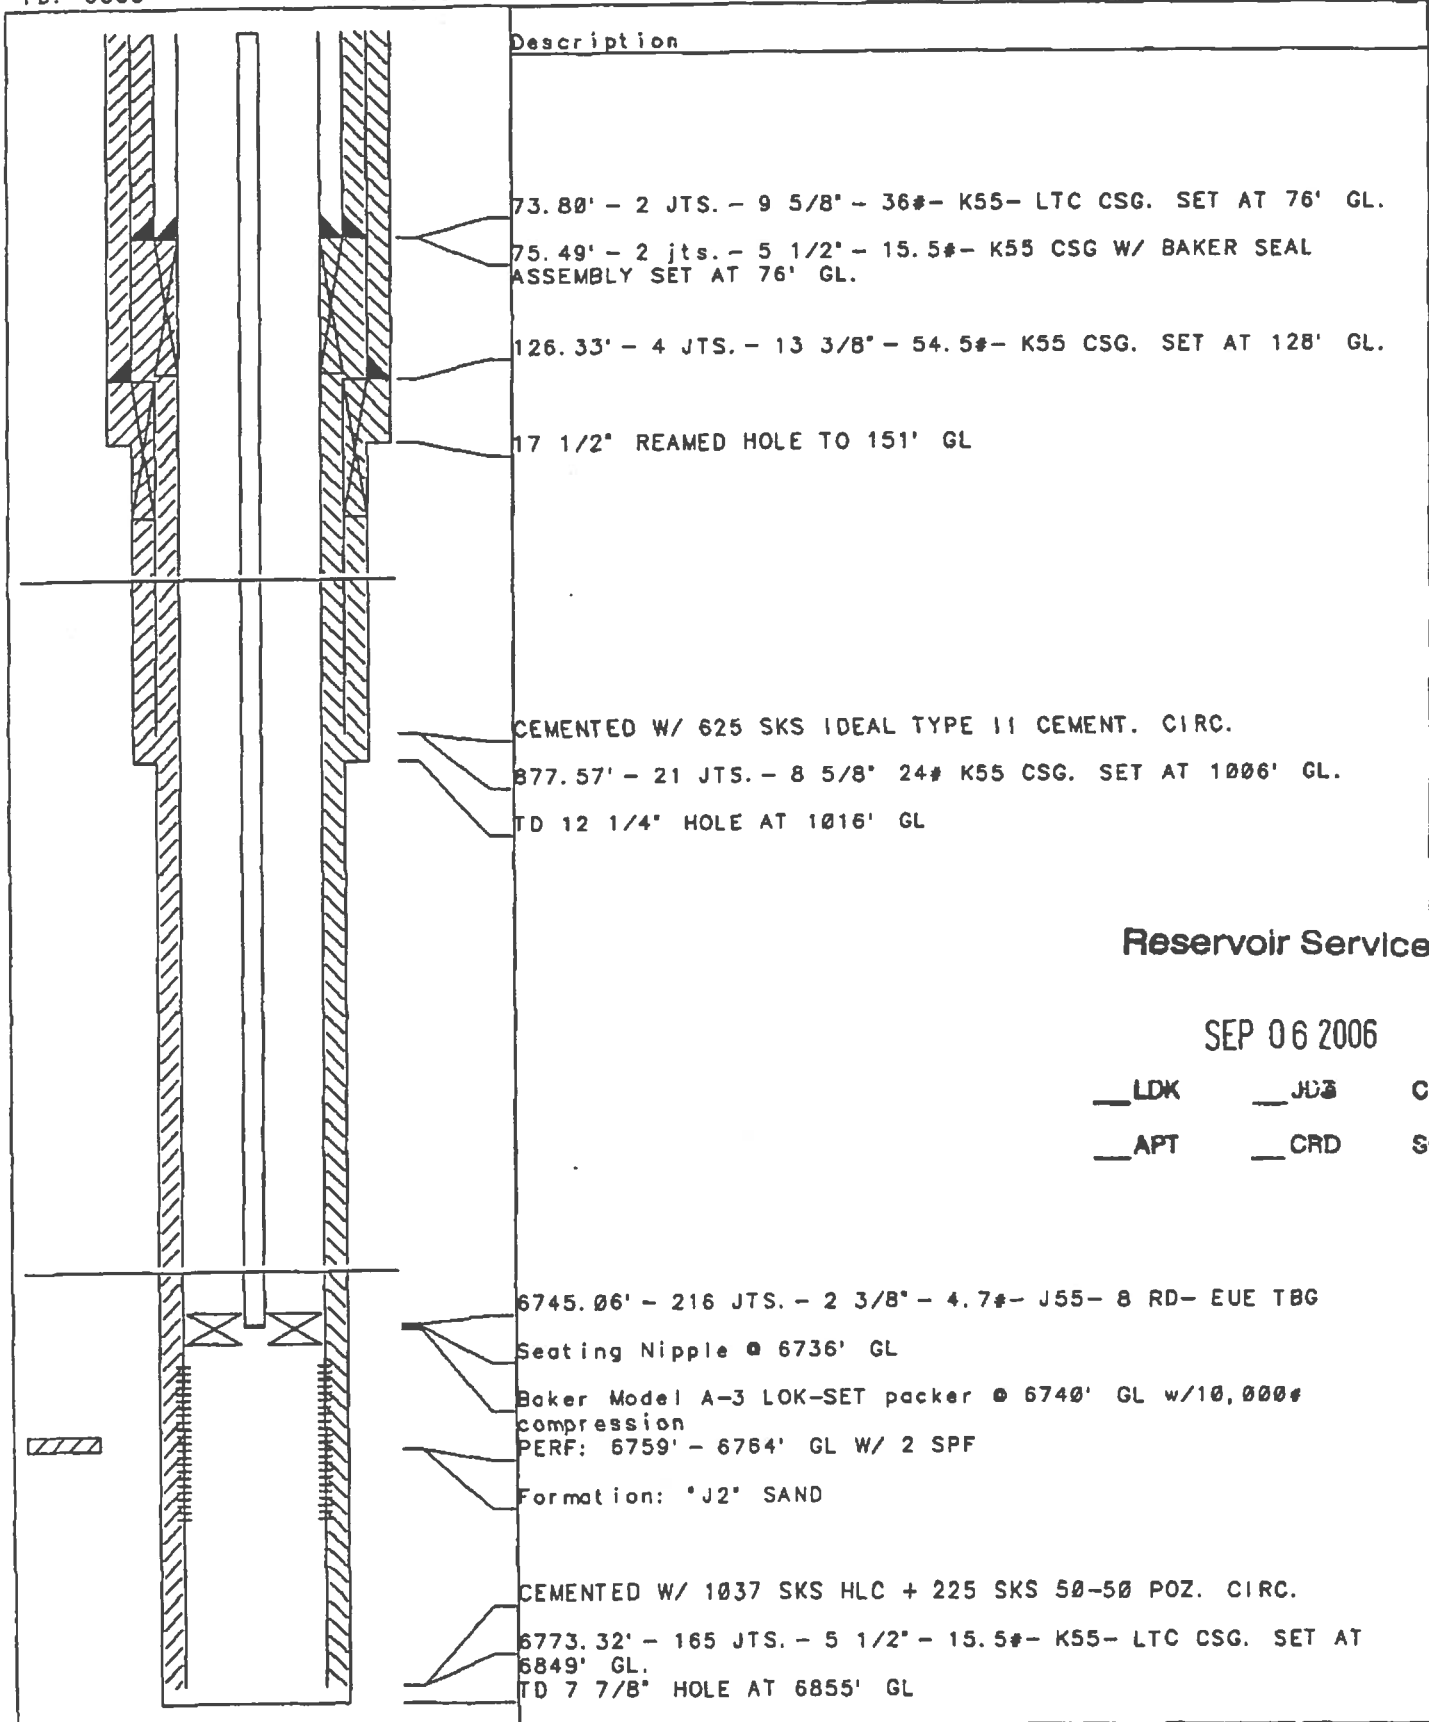

Reservoir Services

SEP 06 2006

___LDK ___JDS Cur
___APT ___CRD FILE
SCA