




Loc # 320655

Lease: LATIGO  
Well #: 40

API #: 05-005-06365-00  
Location: Sec 23 Twn 5S Rng 61W  
County: ARAPAHOE  
State: COLORADO  
Field: LATIGO  
Operator: COLORADO INTERSTATE GAS CO.

Spud Date: 04/28/1979  
KB: 0  
TD: 6923

Plot Date: 11/08/2005  
ELEV: 5509  
PBD: 6898

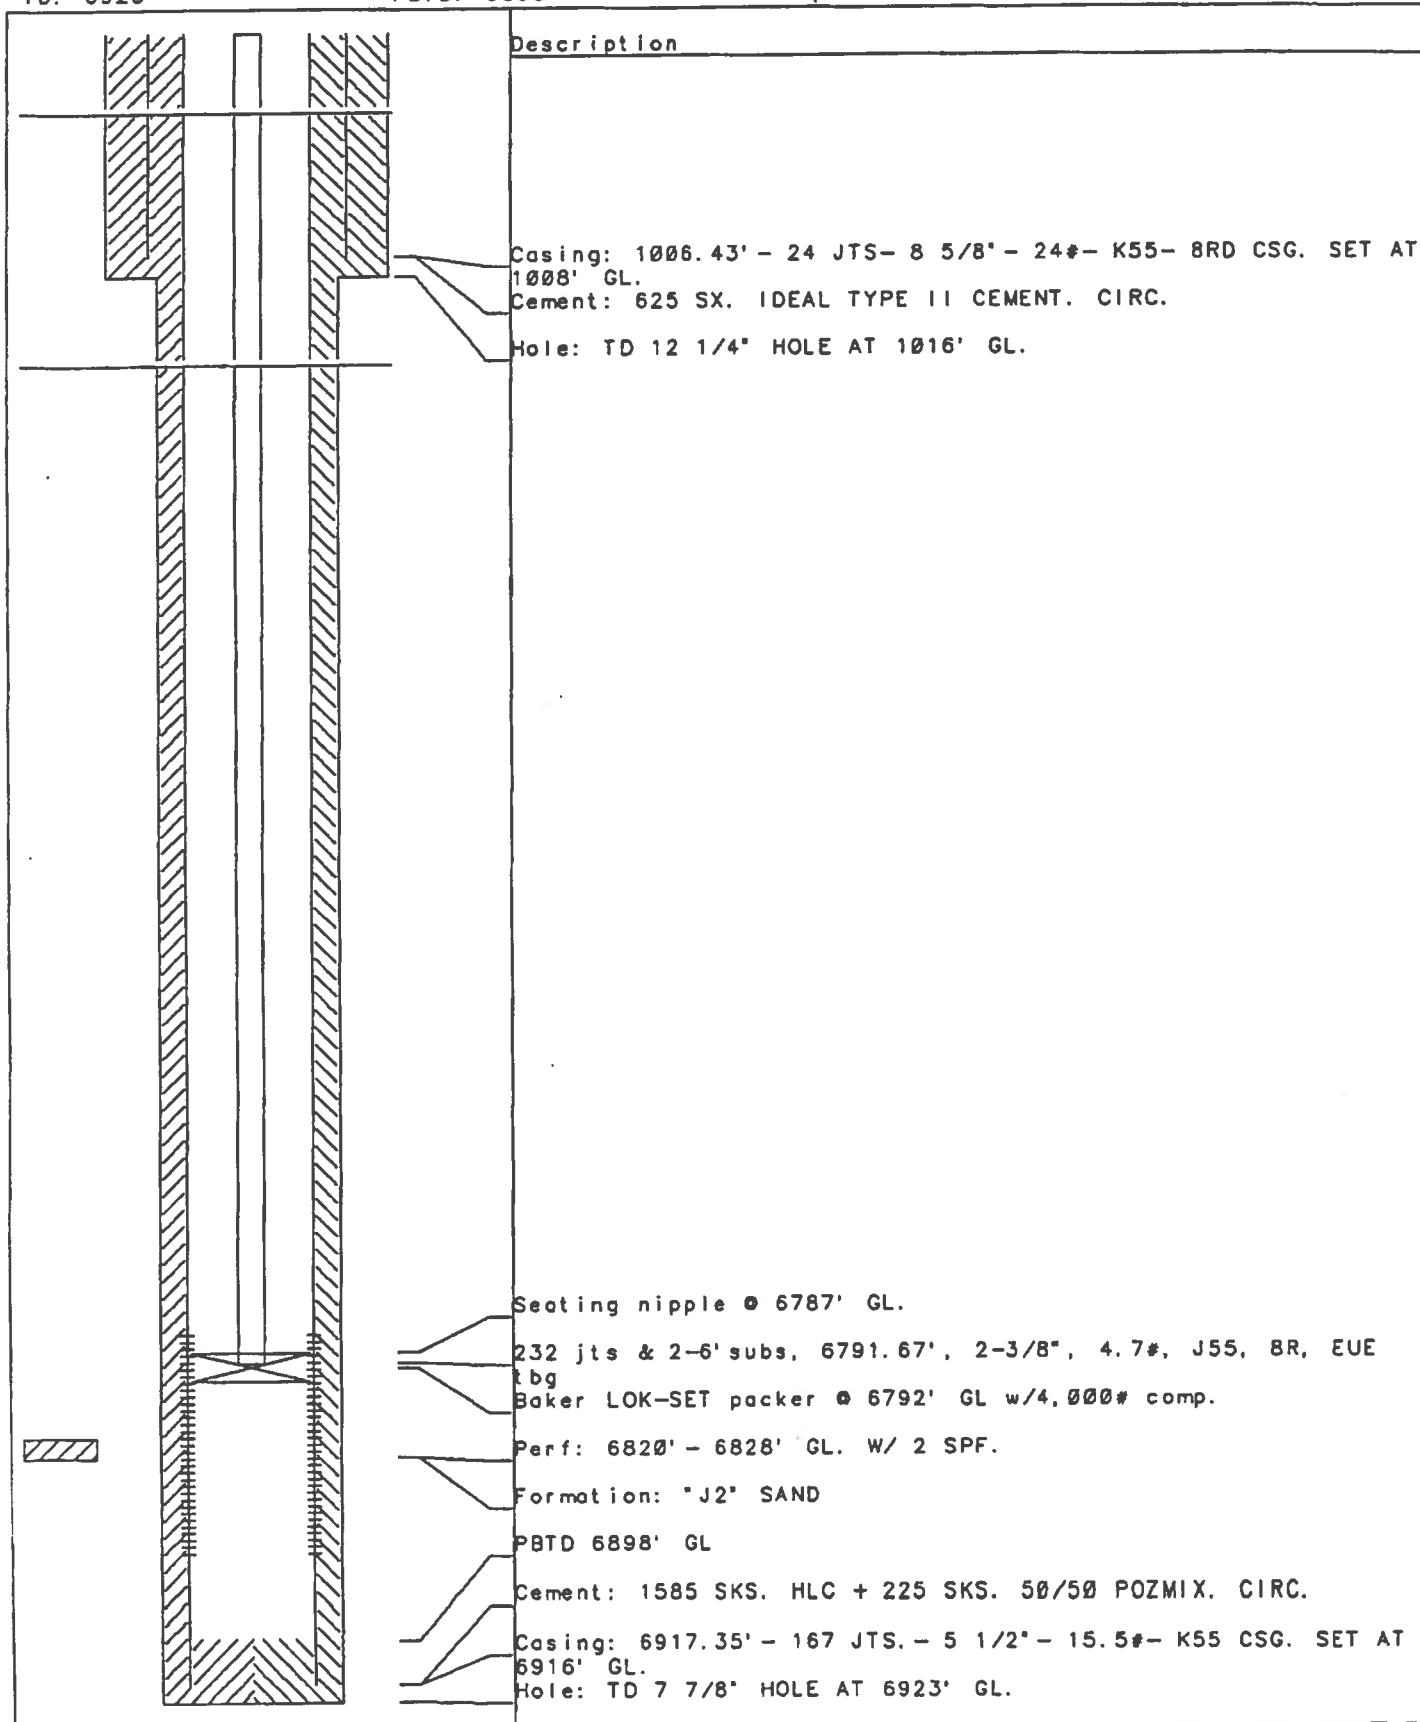

Rec: 11/11/05