




05-005 00590
LOC # 320650

Lease: LATIGO
Well #: 33

API #: 05-005-06400-00
Location: Sec 7 Twn 5S Rng 60W
County: ARAPAHOE
State: COLORADO
Field: LATIGO
Operator: COLORADO INTERSTATE GAS CO.

Spud Date: 04/12/1978
KB: 0
TD: 6765

Plot Date: 11/08/2005
ELEV: 5386
PBD: 6743

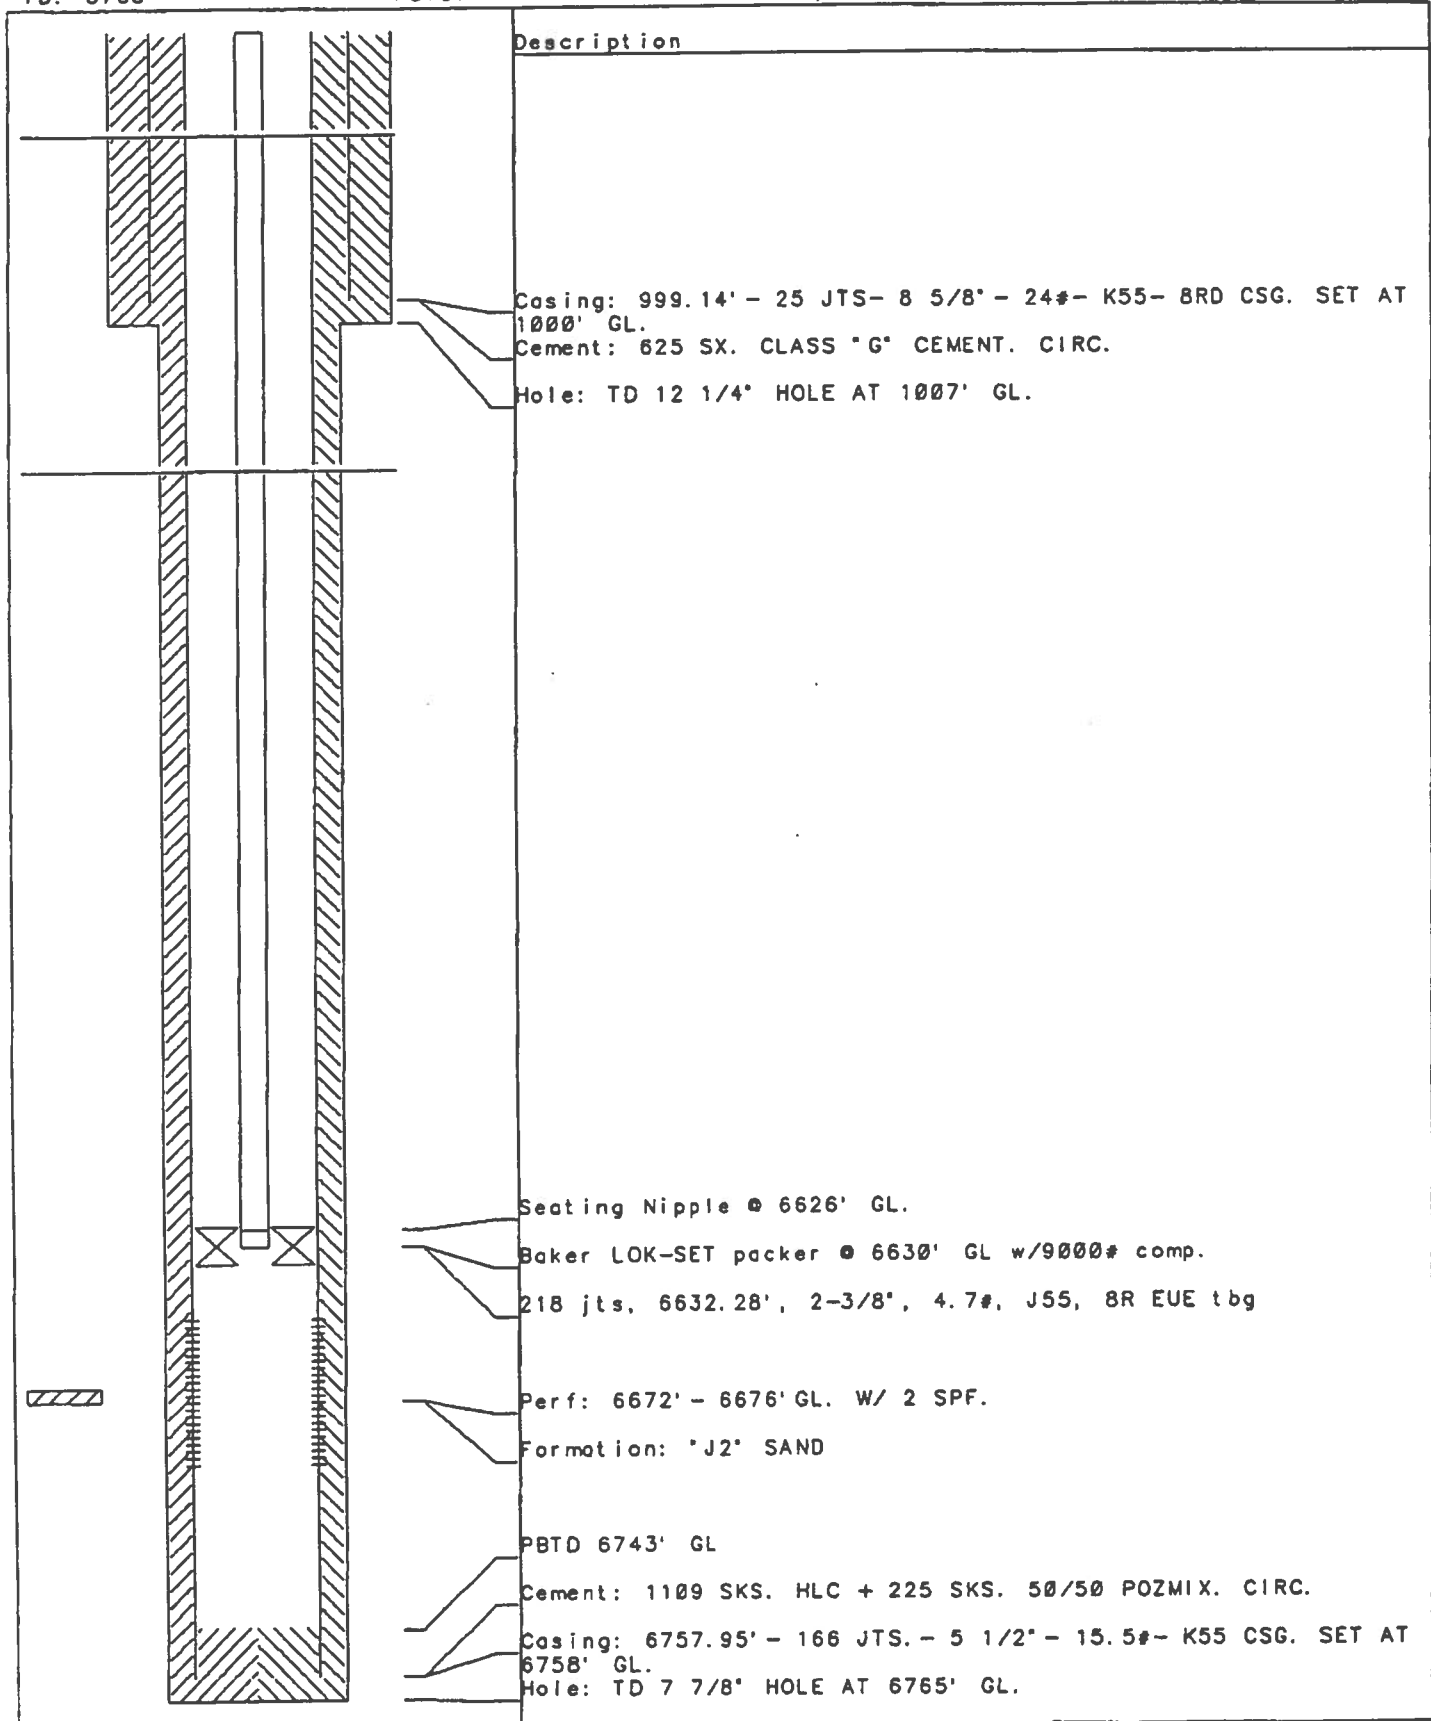

Rec 11/11/05