


Well Name: LILLI UNIT 14-7

VERTICAL - Original Hole, 5/27/2015 7:33:41 AM

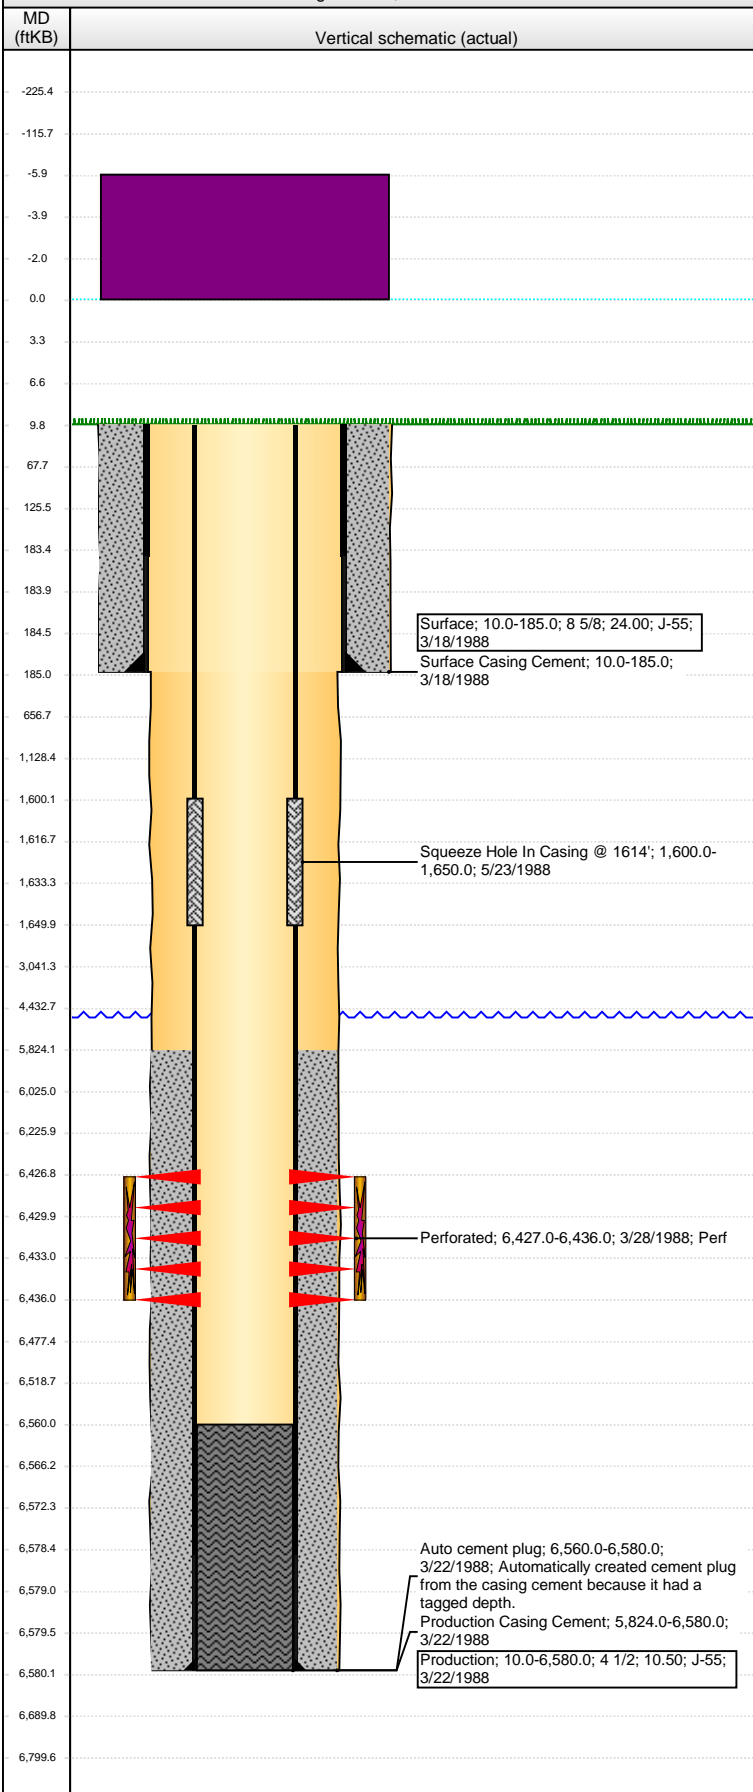

Well Header

API 05-123-13884	Business Unit DJ BASIN	District 25	Well Config VERTICAL
Original KB Elevation (ft) 4,744.00	KB - GL / MSL (ftKB) 10.00	Spud Date 3/18/1988	P & A Date

Comment
No tubing detail.

Directions To Well

Congressional Location

Quarter 1	Quarter 2 NE	Quarter 3 SE	Quarter 4 SW	Section 7	Township 8 N	Twntshp N...	Range 58	Rng E/W Dir W
-----------	-----------------	-----------------	-----------------	--------------	-----------------	--------------	-------------	------------------

Bottom Hole Location

North-South Distance (ft)	From N or S Line	East-West Distance (ft)	From E or W Line
---------------------------	------------------	-------------------------	------------------

Plug Back Total Depths

Date	Depth (ftKB)	Method	Com
------	--------------	--------	-----

Wellbore Sections

Section Des	Size (in)	Act Top, MD (ftKB)	Act Btm, MD (ftKB)
SURFACE	12 1/4	10.0	185.0
PRODUCTION	7 7/8	185.0	6,580.0

Zone Statuses

Zone Name	Status Date	Status	Fluid Type	Job	Prod Method
-----------	-------------	--------	------------	-----	-------------

Casing Strings

Surface, 185.0ftKB

Casing Description	Run Date	OD (in)	Wt/Len (l...)	Grade	Top, MD (ft...)	MD (ftKB)
Surface	3/18/1988	8 5/8	24.00	J-55	10.0	185.0

Production, 6,580.0ftKB

Casing Description	Run Date	OD (in)	Wt/Len (l...)	Grade	Top, MD (ft...)	MD (ftKB)
Production	3/22/1988	4 1/2	10.50	J-55	10.0	6,580.0

Cement

Description	Top Depth (ftKB)	Bottom Depth (ftKB)
Surface Casing Cement	10.0	185.0
Production Casing Cement	5,824.0	6,580.0
Squeeze Hole In Casing @ 1614'	1,600.0	1,650.0

Tubing Strings

Tubing Description	Run Date	String...	ID (in)	Wt (lb/ft)	Grade	Len (ft)	Set De...
--------------------	----------	-----------	---------	------------	-------	----------	-----------

Perforation Data

Zone	Bnch/St g	Entered Shot Total	Top (ftKB)	Btm (ftKB)	Date
D SAND, Original Hole		19	6,427.00	6,436.00	3/28/1988

Stimulations & Treatments

Date 5/27/1988	Zone D SAND, Original Hole	Primary Job Type DRILLING/COMPLETION - ORIGINAL
Technical Result	Tech Result Details	Tech Result Note

Comment

Other In Hole

Run Date	Des	OD (in)	Top (ftKB)	Btm (ftKB)
----------	-----	---------	------------	------------

Logs

Date	Type	Top, MD (ftKB)	Btm, MD (ftKB)
------	------	----------------	----------------