



Tree

Berm

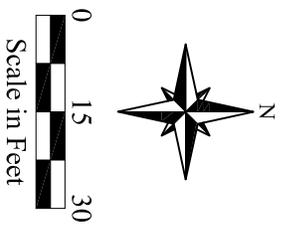

Legend	
•	Sample Location
◆	COGCC Levels
	TPH = 500
	B = 0.17
	T = 85
	E = 100
	X = 175

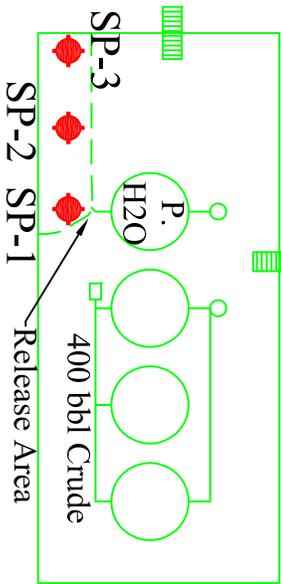

Date: 05/11/2015

Scale: 1" = 30'

Drawn By: TJS

Wolf 35

Whiting Oil & Gas Corporation  
Weld County, Colorado  
Figure 1 - Site Plan