


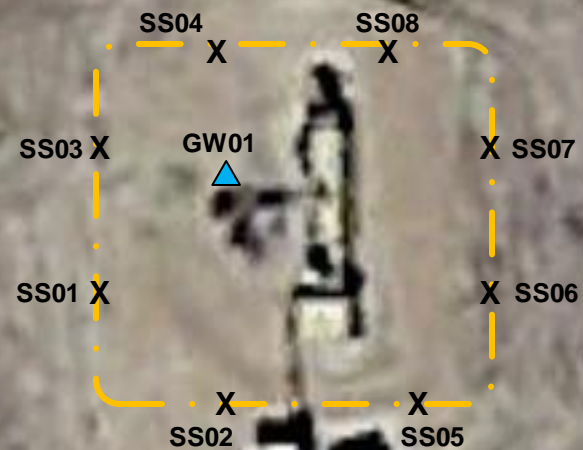


Surface
Drainage
Indiscernible



Access Road

Agriculture

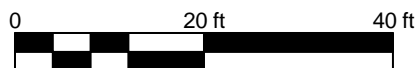

DRAWN BY: ESS

DATE: 5/14/2015

Facility Diagram
PDC Energy, Inc. – DJ Basin
Miller GJ 33-24
NWSE S24 T6N R65W
Weld County, CO



6899 Pecos Street, Unit C
Denver, CO 80221

LEGEND

- Approximate Area of Excavation
- DCP Gas Line
- Soil Sample Location
- Groundwater Sample Location

FIGURE 2
EXCAVATION
SITE MAP