





Lat40°, Inc. 6250 W. 10th Street, Unit 2, Greeley, CO 970-515-5294

WELL LOCATION CERTIFICATE

FAGERBERG FEDERAL I12-615

SECTION: 12
TOWNSHIP: 6N
RANGE: 66W
6TH. P.M.
WELD COUNTY, CO

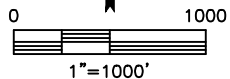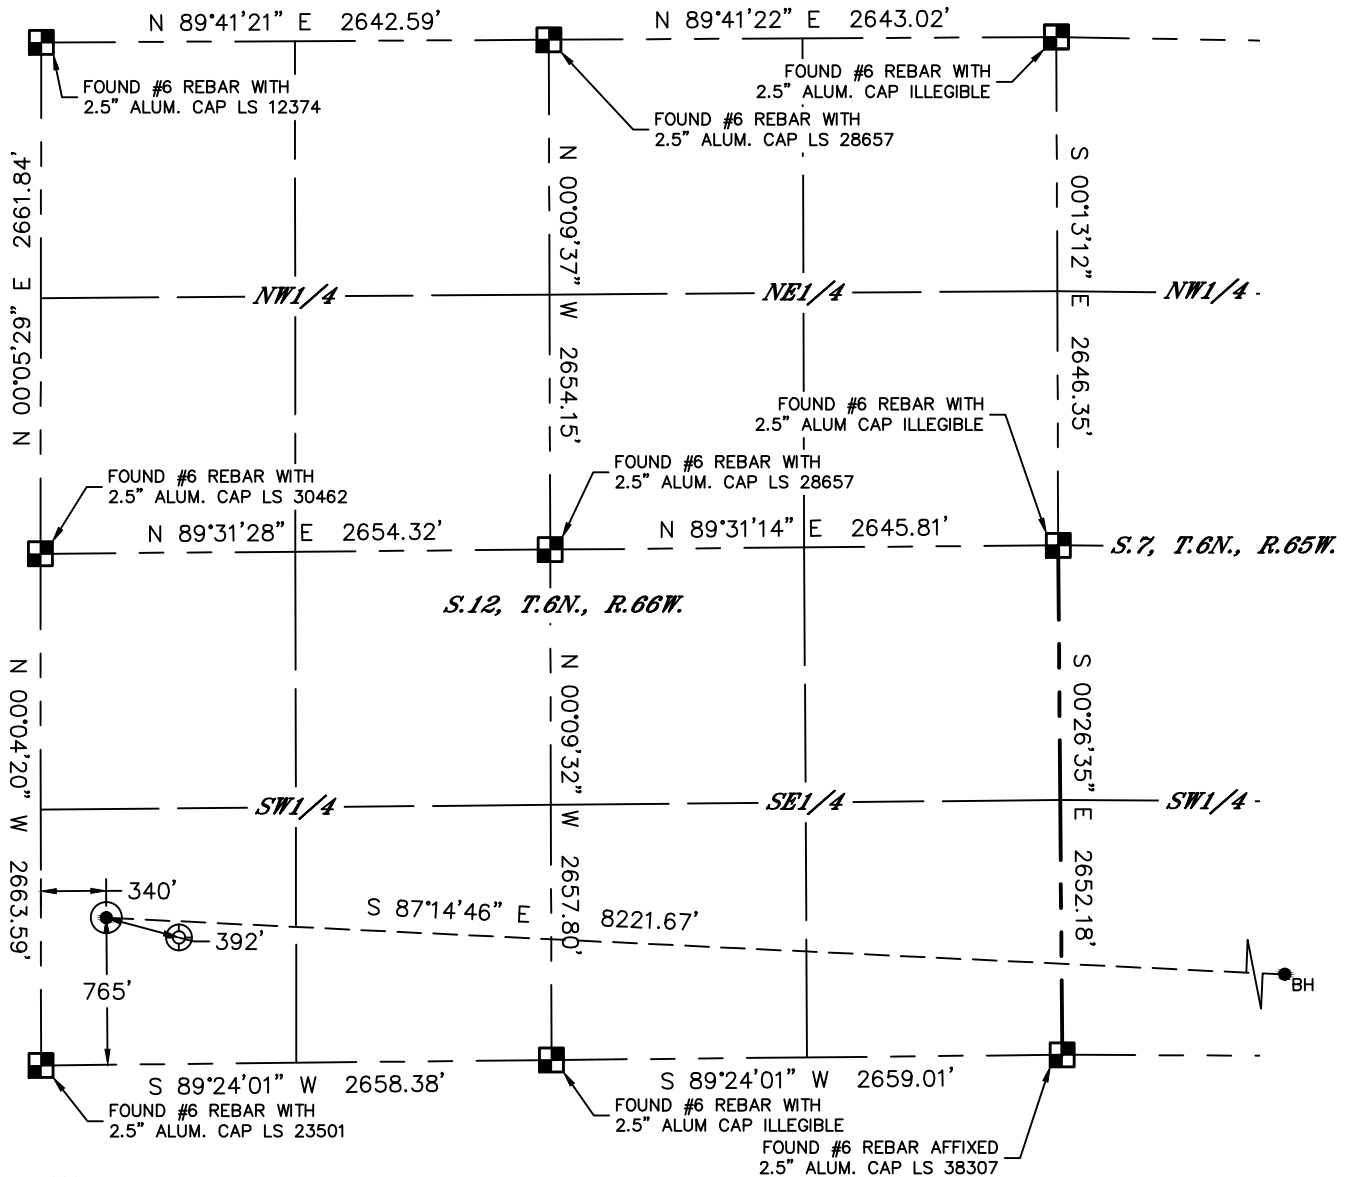

CLIENT: NOBLE ENERGY, INC						LANDMAN: PRESTON FOSTER			
INSTRUMENT OPERATOR: ADAM BEAUPREZ						SURVEY DATE: 1/15/2015		SURFACE USE: CROP LAND	
SHL FOOTAGE				SHL LAT °	SHL LONG °	SHL PDOP	SHL ELEV	SHL 1/4/1/4	SHL S-T-R
765	FSL	340	FWL	40.49767	-104.73376	2.3	4800	SWSW	12-6-66

BHL FOOTAGE				BHL LAT °	BHL LONG °	BHL S-T-R
330	FSL	2040	FEL	40.49639	-104.70425	7-6-65


NOTE:

- 1) Bearings shown are Grid Bearings of the Colorado State Plane Coordinate System, North Zone, North American Datum 1983. The lineal dimensions as contained herein are based upon the "U.S. Survey Foot."
- 2) Distances to section lines measured at 90 degrees from said section lines.
- 3) Ground elevations are based on an observed GPS elevation (NAVD 1988 DATUM).
- 4) Latitude and Longitude shown are (NAD 83 DATUM).
- 5) IMPROVEMENTS: See LOCATION DRAWING for all visible improvements within 500' of oil and gas location.
- 6) This map does not represent a Land Survey Plat or an Improvement Survey Plat, and that it is not to be relied upon for establishment of fence, building, or other future improvement lines.

NEAREST CULTURAL ITEMS	
EX. OTTOSON 3	±392' SE
BUILDING	±678' SE
BUILDING UNIT	±703' SE
HIGH OCCUPANCY BUILDING UNIT	5280'+
DESIGNATED OUTSIDE ACTIVITY AREA	5280'+
PUBLIC ROAD (COUNTY ROAD 35)	±327' W
ABOVE GROUND UTILITY	±368' W
RAILROAD	5280'+
PROPERTY LINE	±340' W

LEGEND

- = ALIQUOT MONUMENT AS DESCRIBED
- = CALCULATED POSITION
- = SURFACE HOLE LOCATION (SHL)
- ▲ = ENTRY POINT LOCATION (EP)
- BH = BOTTOM HOLE LOCATION (BHL)
- ⊕ = EXISTING WELL
- ⊗ = ABANDONED WELL

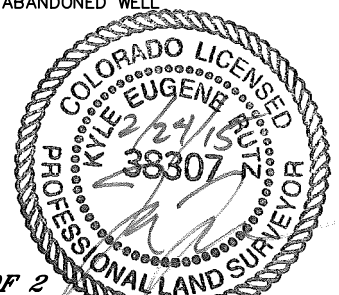

SHEET 1 OF 2


Kyle E. Rutz—On behalf of Lat40, Inc.
Colorado Licensed Professional Land Surveyor No. 38307
DATE: 2/24/2015
PROJECT#: 2014145

Lat40°, Inc. 6250 W. 10th Street, Unit 2, Greeley, CO 970-515-5294





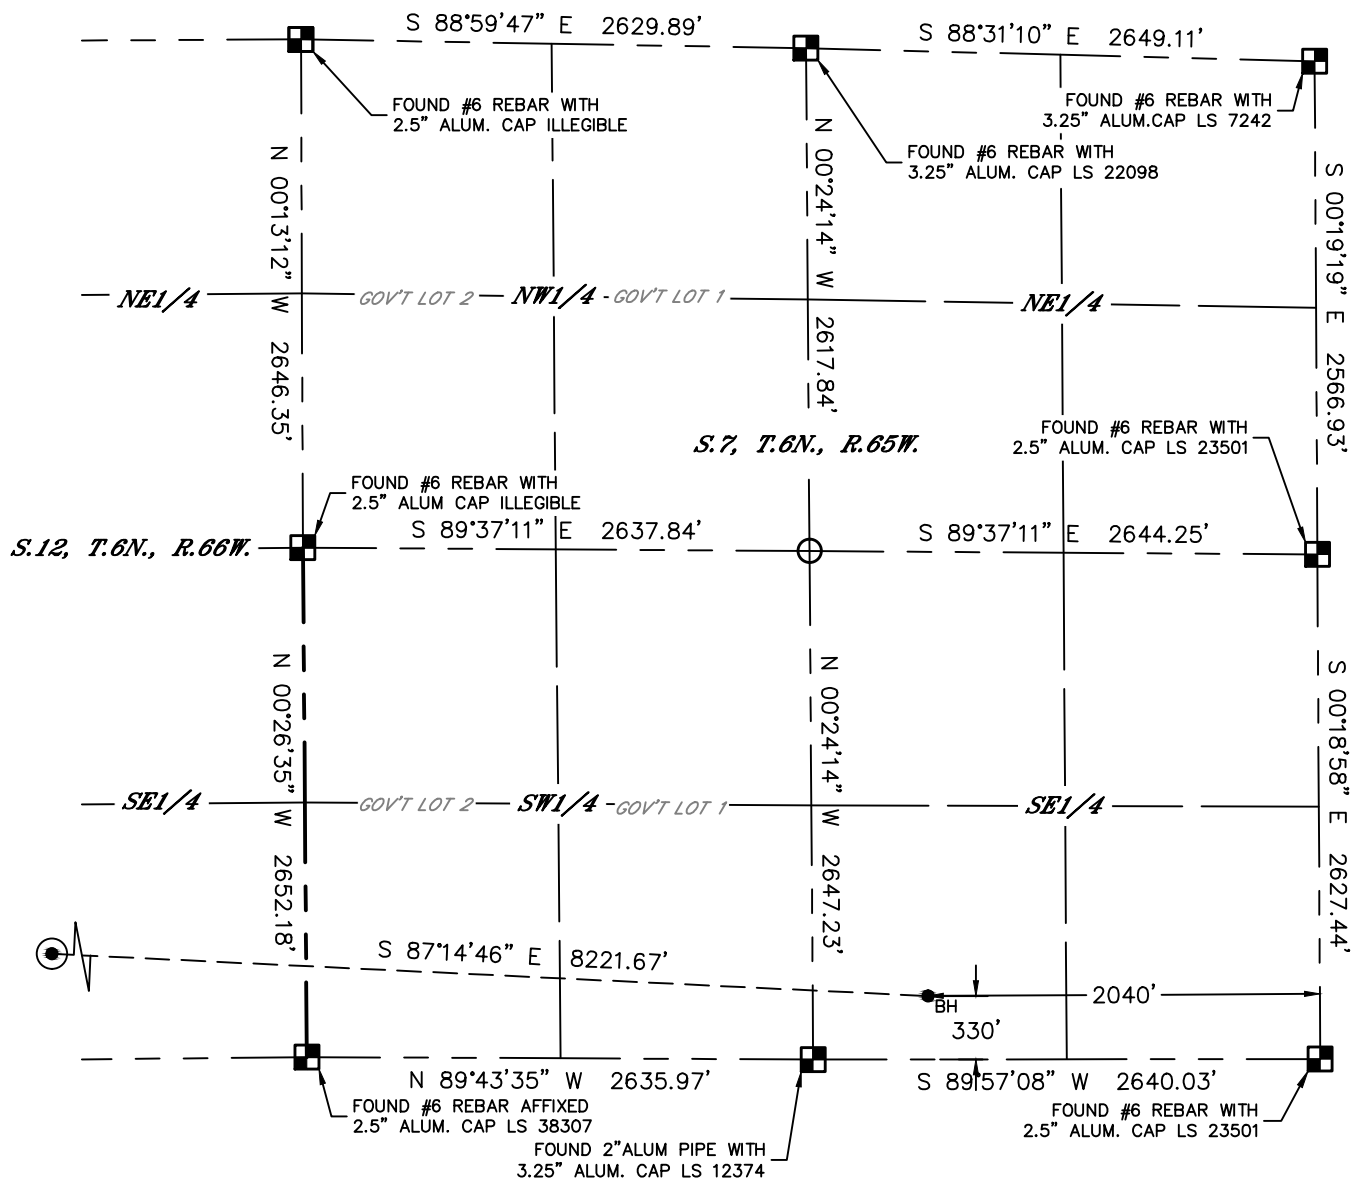


WELL LOCATION CERTIFICATE



FAGERBERG FEDERAL I12-615

SECTION: 12
TOWNSHIP: 6N
RANGE: 66W
6TH. P.M.
WELD COUNTY, CO



LEGEND

-  = ALIQUOT MONUMENT AS DESCRIBED
 = CALCULATED POSITION
 = SURFACE HOLE LOCATION (SHL)
 = ENTRY POINT LOCATION (EP)
 = BOTTOM HOLE LOCATION (BHL)
 = EXISTING WELL
 = ABANDONED WELL

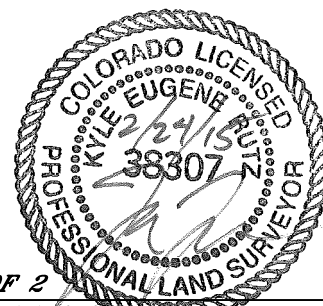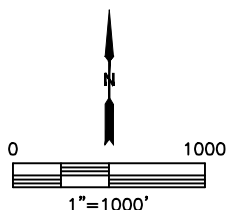

SHEET 2 OF 2

Kyle E. Rutz—On behalf of L&L, Inc.
Colorado Licensed Professional Land Surveyor No. 38307
DATE: 2/24/2015
PROJECT#: 2014145