


**Note:**  
 The measurement for determining any Designated Setback Location shall be made from the center of the Well nearest any Building Unit to the nearest wall or corner of such Building Unit.

Building	-	466'
Building Unit	-	466'
HOB	-	1555'
DOA	-	N/A
Public Road	-	872'
Above Grnd Util.	-	892'
Railroad	-	5280'+
Property Line	-	219'

Current Surface Land Use :  
 Gas Pad

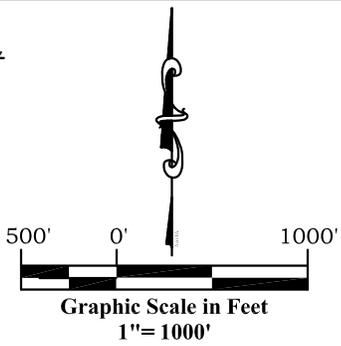

- Legend**
- ◊ - Field Surveyed Section Corner
  - ◆ - Field Surveyed Quarter Corner
  - ⊙ - Calculated Section Corner Location
  - ⊕ - Field Surveyed 1/6 Corner


**Surface:**  
**Yater 22C-17-07-95**  
 1767' FSL  
 1106' FWL  
 Gnd El= 5517  
 Pad El= 5517  
**NAD83**  
 Lat: 39.435296133°N  
 Long: 108.026479625°W

**Notes:**

1. LATITUDE AND LONGITUDE COORDINATES ARE DIFFERENTIALLY CORRECTED AND BASED ON PUBLISHED NGS CONTROL STATION "WDP-5". SYSTEM: UTM ZONE: 13 NORTH DATUM: NAD 1983 (CONUS)
2. ELEVATIONS ARE BASED ON NAVD OF 1988.
3. ALL BOTTOM AND TOP HOLE LOCATIONS ARE MEASURED 90 DEGREES FROM SECTION LINE.
4. USGS QUADRANGLE MAP "PARACHUTE".
5. CURRENT SURFACE LAND USE: GAS PAD.
6. PDOP AT THE TIME OF LOCATION OF SURFACE WELL = 1.5

**SURVEYOR'S CERTIFICATE**

I, SCOTT E. AIBNER, A REGISTERED LAND SURVEYOR, LICENSED UNDER THE LAWS OF THE STATE OF COLORADO DO HEREBY CERTIFY THAT THE SURVEY SHOWN HEREON WAS PREPARED BY RIVER VALLEY SURVEY, INC. FOR URSA OPERATING COMPANY, LLC, BY ME OR UNDER MY DIRECT SUPERVISION AND THAT THIS PLAT IS A TRUE REPRESENTATION THEREOF.

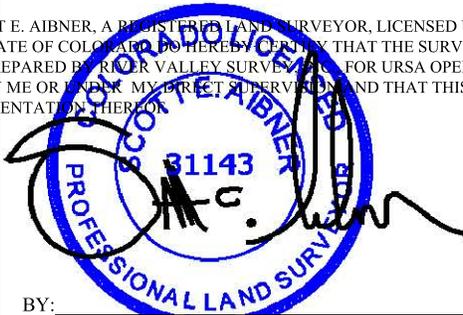

BY: SCOTT E. AIBNER, COLORADO REG. NO. 31143

Prepared For Ursa Operating Company, LLC  
 As Drilled 22C-17-95 Well, Surface Situate in The  
 NW 1/4 SW 1/4 Section 17, Township 7 South, Range  
 95 West of the 6 th. Principal Meridian, County of  
 Garfield, State of Colorado.



**River Valley Survey, Inc.**  
 110 East 3rd. Street, Suite 213  
 Rifle, Colorado 81650  
 Ph: 970-379-7846

Project: RVS 06001-60	
Field Date: 3-04-15	Scale: 1"= 1000'
Date: 5-12-15	Sheet: 1 of 1

**Yater Pad**  
**As-Drilled Plat**  
**22C-17-07-95**  
 Section 17, Township 7 South, Range 95 West