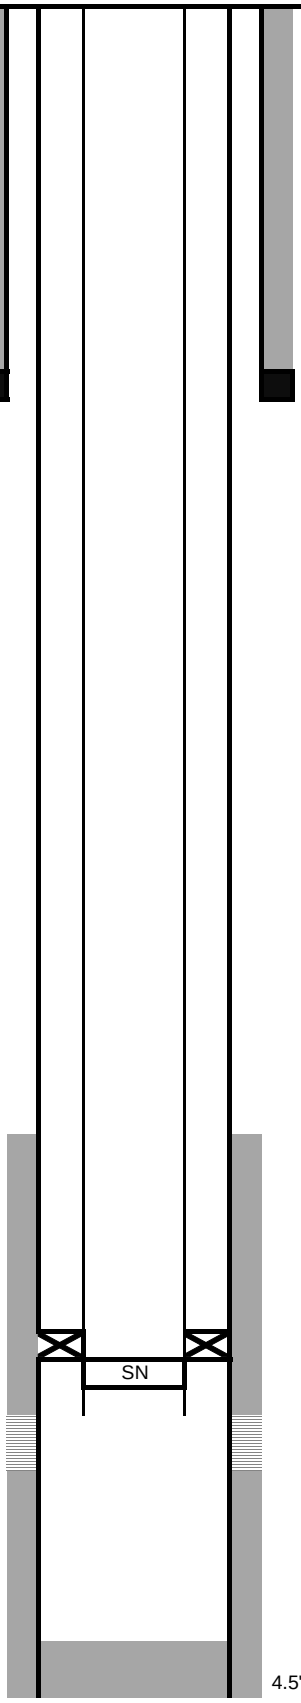

Not to Scale

8 5/8"
Surf Csg @ 344'
TOC: Circ

TOC: TOC Unknown

Packer @ 2908'

Top Perf: 2952'

Bot Perf : 2986'

4.5" Csg set @: 3101'

TD 3103'

PBTD: 3062'

Wellbore Dia		Price 2-20			
Status	Producing		Operator	Stelbar Oil Corp	
Lease	Price		Zone	Niobrara	
Field	Denova		API	05-121-09686-00	
State:	Colorado		Division:		
Location	1400' FSL & 1400' FWL, E/2 SW/4 Sec 20-T2S-R49W, 6th PM, Washington County, CO: ? Acre Spacing				
Reference:					
KB	4,467	TVD	3103'	Orig PBTD	3062'
GL	4,460	MTD	3103'	SN	

Casing	Weight/Grade	Depth	Cmt Sx	Hole	TOC
N/A Conductor					
8 5/8"	24#/K-55	344'	300	12 1/4"	Circ
4.5"	10.5#,K-55	3101'	150 sx 50/50 Poz	7 7/8"	TOC Unknown

Spud	6/16/1981	Top Perf	2952'	
Completion	6/25/1981	Bot Perf	2986'	

Perf: 2952'-2986', 34' @ 2 JSPF, 68 holes. Stim with 29,000 gal water & CO2 & 100,000 lbs sand 1-5 PPG.

Date sketch checked	**6/10/15**	by:	TWL	
Date tubulars checked	**6/10/15**	by:	TWL	

Current Tubulars

Tubing String					
Size	Grade	# Jnts	Type	Length, ft	Depth, ft
			KBE	7.00	7.00
2 3/8	J-55	92	Plain Tbg	2898.00	2905.00
2 3/8		1	SN	1.10	2906.10
2 3/8		1	Packer	2.00	2908.10
					2908.10
			Bottom of Tbg String:		2908.10

Rods String				
Size	Grade	# Rods	Length, ft	Depth, ft

Latitude and Longitude Location:	
Latitude:	**39.862718**
Longitude:	**-102.890943**