Exploration and Production

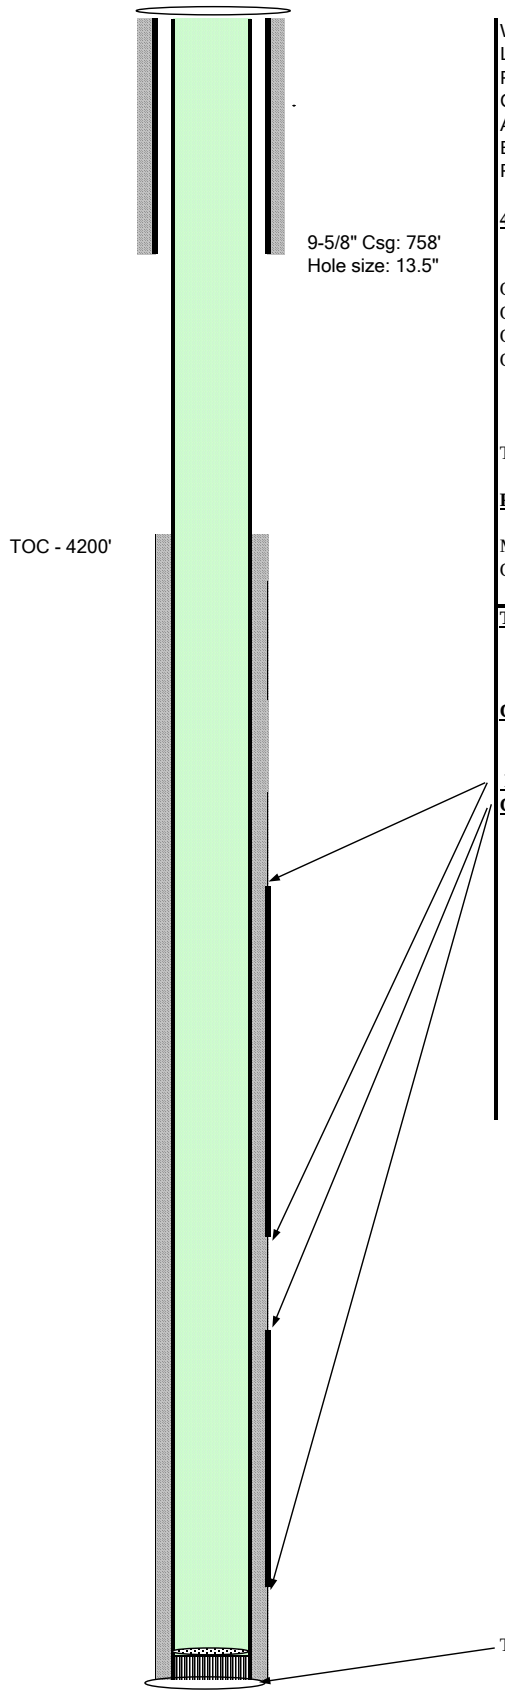

Well Name	**GM 238-36**	
Location	**SWSE 36 6S 96W**	
Field	**Grand Valley**	
County	**Garfield, CO**	
API	**05-045-07918**	
ELEV	5,442'	
Footages	828 FSL, 2428 FEL	

4/26/2002

Casing	**758'**	**9-5/8" 32.3# H-40**
Cement	340 sx	
Casing	**6812'**	**4-1/2" 11.6# I-80**
Cement	705 sx	
Tubing	**6097'**	

Formation Tops

Mesaverde	3530'
Cameo	6012'

TOC - Bond Log **4200'**

Completed Intervals

	Depth	**# Holes**
MV	5089 -6225	50
Cameo	6360-6618	20

TD **6812', 4-1/2" Csg, Hole Size, 7-7/8"**