


Note:
 The measurement for determining any Designated Setback Location shall be made from the center of the Well nearest any Building Unit to the nearest wall or corner of such Building Unit.

Building	-	617'
Building Unit	-	730'
HOBUs	-	2526'
DOAA	-	N/A
Public Road	-	1036'
Above Grnd Util.	-	1065'
Railroad	-	5280'+
Property Line	-	273'

Current Surface Land Use :
 Gas Pad

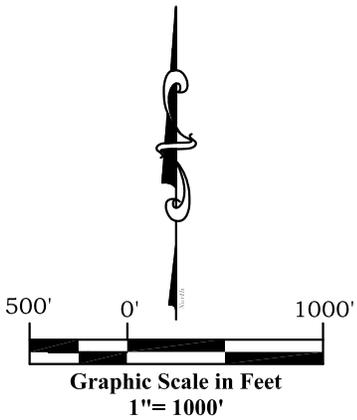

Legend

- ◊ - Field Surveyed Section Corner
- ◆ - Field Surveyed Quarter Corner
- ⊙ - Calculated Section Corner Location
- ⊕ - Field Surveyed 1/6 Corner

Notes:

1. LATITUDE AND LONGITUDE COORDINATES ARE DIFFERENTIALLY CORRECTED AND BASED ON PUBLISHED NGS CONTROL STATION "WDP-5". SYSTEM: UTM ZONE: 13 NORTH DATUM: NAD 1983 (CONUS)
2. ELEVATIONS ARE BASED ON NAVD OF 1983.
3. ALL BOTTOM AND TOP HOLE LOCATIONS ARE MEASURED 90 DEGREES FROM SECTION LINE.
4. USGS QUADRANGLE MAP "PARACHUTE".
5. CURRENT SURFACE LAND USE: GAS PAD.
6. PDOP AT THE TIME OF LOCATION OF SURFACE WELL = 1.2
7. GPS OPERATOR: P. HOFFMANN

As-Drilled Surface:
Watson Ranch B 24AWI-17-07-95

1047' FSL
 1978' FWL
 Gnd El= 5585
 Pad El= 5585
NAD83

Lat: 39.433335123°N
 Long: 108.023363099°W

SURVEYOR'S CERTIFICATE

I, SCOTT E. AIBNER, A REGISTERED LAND SURVEYOR, LICENSED UNDER THE LAWS OF THE STATE OF COLORADO DO HEREBY CERTIFY THAT THE SURVEY SHOWN HEREON WAS PREPARED BY RIVER VALLEY SURVEY, INC., FOR URSA OPERATING COMPANY LLC, BY ME OR UNDER MY DIRECT SUPERVISION AND HAS BEEN STAKED ON THE GROUND AS SHOWN ON THE PLAT AND THAT THIS PLAT IS A TRUE REPRESENTATION THEREOF.



BY: _____
 SCOTT E. AIBNER, COLORADO REG. NO. 31143

Prepared For: Ursa Operating Company LLC
As-Drilled Watson Ranch B 24AWI-17-07-95 Well,
Surface Situate in The SE1/4SW1/4 Section 17, Township 7
South, Range 95 West of the 6 th. Principal Meridian,
County of Garfield, State of Colorado.



RVS River Valley Survey, Inc.
 110 East 3rd. Street, Suite 213
 Rifle, Colorado 81650
 Ph: 970-379-7846

Project: RVS 06001-31B	
Field Date: 04-07-15	Scale: 1"= 1000'
Date: 06-02-15	Sheet: 1 of 1

Watson Ranch B Pad
As-Drilled Plat
Watson Ranch B 24AWI-17-07-95
 Section 17, Township 7 South, Range 95 West