

MARALEX RESOURCES, INC.

Plugged Wellbore

WELL NAME	South Shale Ridge 10-15	COC	12735
LOCATION	NWSE Section 15 T8S R98W 6 PM		
GPS	39.358663	-108.314112	PDOP 2.5
API #	05-077-08622		

FIELD	South Shale Ridge
COUNTY	Mesa
GPS OPERATOR	M. Nastal
FORMATION	Cameo Coal

CASING

SURFACE

SIZE & WT	9 ⁵ / ₈ " 36#
SET @	133'
HOLE SIZE	12 ¹ / ₄ "
CEMENT	82 sxs reg.
w/ 2% CaCl w/ 1/4 #/sx of cellophane flakes	
Calculated TOC @ surface	

PRODUCTION

SIZE & WT	7" 32#
SET @	3184'
HOLE SIZE	8 ³ / ₄ "
CEMENT	1st stage: 130 sxs G w/ 2% CaCl
	2ond stage: 150 sxs G w/ 3% CaCl w/ 12% Calseal & 10#/sx Gilsonite
TOC 1st stage (calc)	2189'
2ond stage(calc)	833'


STAGE TOOL

@ 1980'

OPEN HOLE 3194'-3291'

FORMATION TOPS

Wasatch	surface
Mesa Verde	1090'
Cameo Coals	3162'
Rollins	3414'

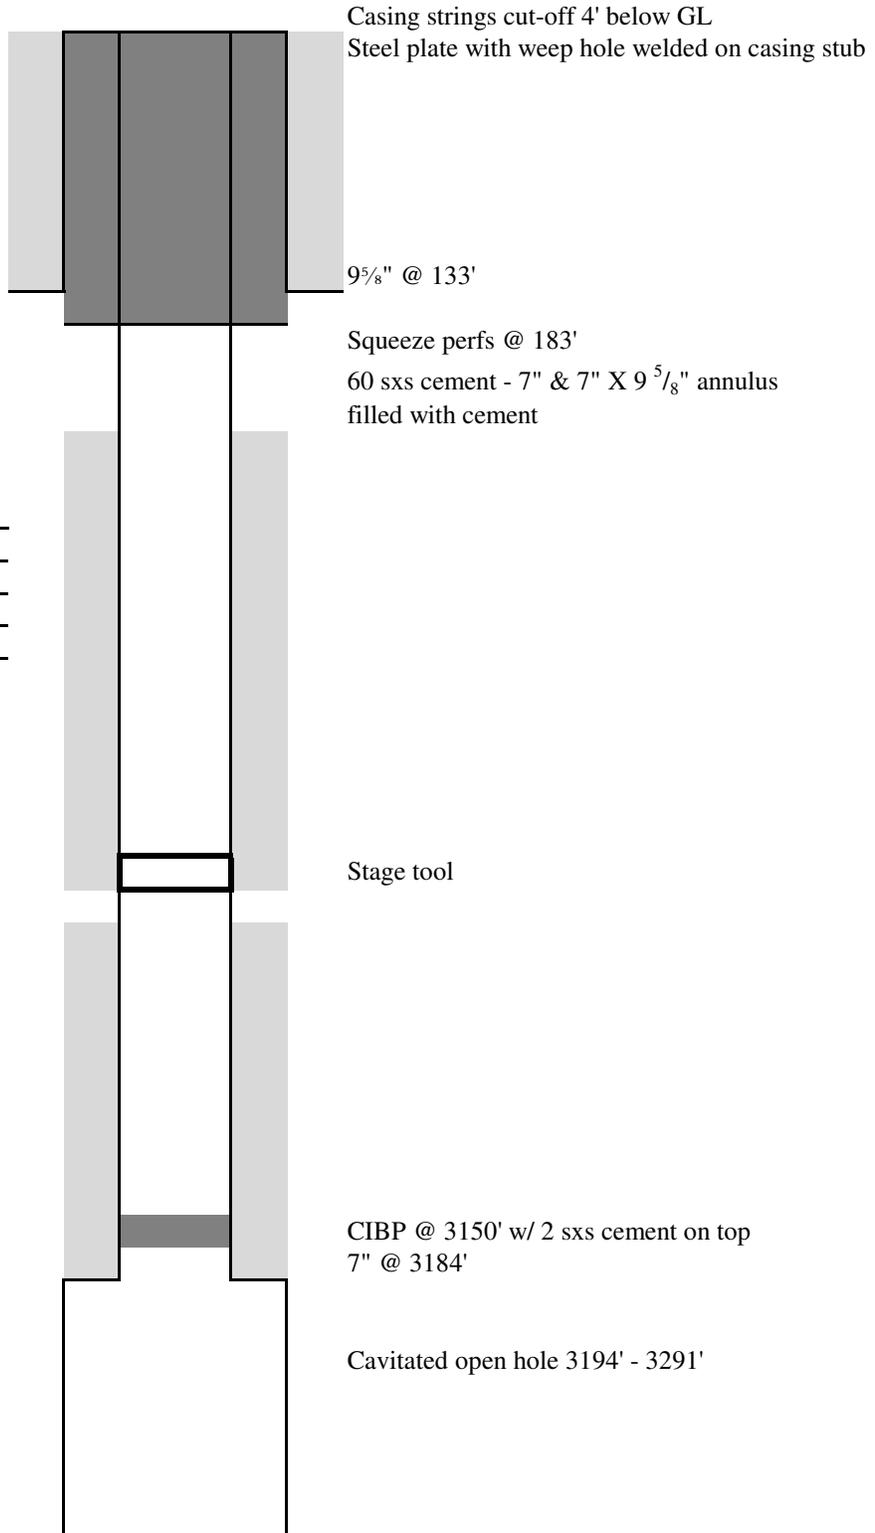

Casing strings cut-off 4' below GL

Steel plate with weep hole welded on casing stub

9⁵/₈" @ 133'

Squeeze perms @ 183'

60 sxs cement - 7" & 7" X 9⁵/₈" annulus filled with cement

Stage tool

CIBP @ 3150' w/ 2 sxs cement on top 7" @ 3184'

Cavitated open hole 3194' - 3291'