



T20S, R69W, 6th P.M.

AUS-TEX EXPLORATION INC

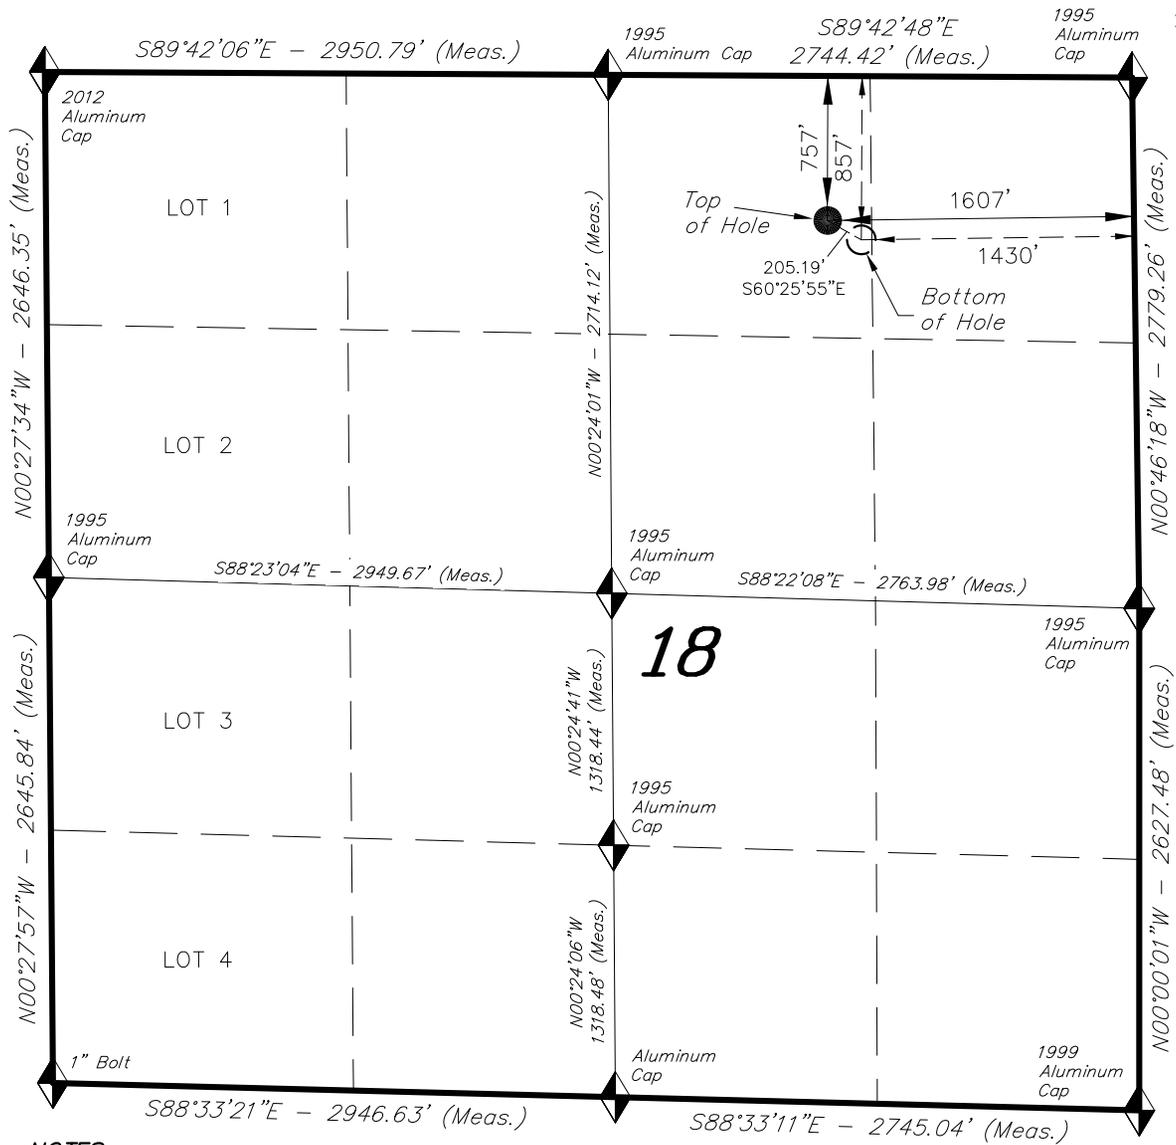

WELL LOCATION, PATHFINDER C18 #2, LOCATED AS SHOWN IN THE NW 1/4 NE 1/4 OF SECTION 18, T20S, R69W, 6th P.M. FREMONT COUNTY, COLORADO.

TARGET BOTTOM HOLE, PATHFINDER C18 #2, LOCATED AS SHOWN IN THE NW 1/4 NE 1/4 OF SECTION 18, T20S, R69W, 6th P.M. FREMONT COUNTY, COLORADO.

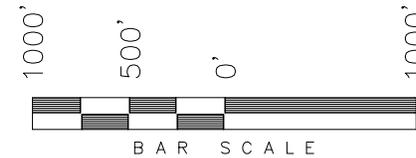

**WELL LOCATION:
PATHFINDER C18 #2**

ELEV. UNGRADED GROUND = 5960.8'

THIS IS TO CERTIFY THAT THE ABOVE PLAT WAS PREPARED FROM FIELD NOTES OF SURVEYS MADE BY ME OR UNDER MY SUPERVISION. THE LOCATION HAS BEEN STAKED ON THE GROUND AS SHOWN ON THE PLAT, AND IS IN MY BEST AND TRUE AND CORRECT KNOWLEDGE AND BELIEF.

Stacy C. Petty
REGISTERED LAND SURVEYOR
REGISTRATION NO. 97025
STATE OF COLORADO

NOTES:

- Well footages are measured at right angles to the Section Lines.
- Bearings are based on Global Positioning Satellite observations.
- G.P.S. Operator: D. Petty, (PDOP) = 1.2

BASIS OF ELEV;
U.S.G.S. 7-1/2 min QUAD (Rockvale)

◆ = SECTION CORNERS LOCATED

NAD 83 (SURFACE LOCATION)	
LATITUDE	= 38°18'49.67" (38.313796°)
LONGITUDE	= 105°08'53.45" (105.148180°)
NAD 83 (BOTTOM HOLE LOCATION)	
LATITUDE	= 38°18'48.67" (38.313518°)
LONGITUDE	= 105°08'51.21" (105.147558°)

TRI STATE LAND SURVEYING & CONSULTING
180 NORTH VERNAL AVE. - VERNAL, UTAH 84078
(435) 781-2501

DATE SURVEYED: 06-05-15	SURVEYED BY: D.P.	SHEET 1
DATE DRAWN: 06-08-15	DRAWN BY: F.T.M.	
REVISED:	SCALE: 1" = 1000'	