




BY Cherokee-Pittsburg 535	DATE API 05-043-40002	SHEET NO.
------------------------------	--------------------------	--------------

Existing

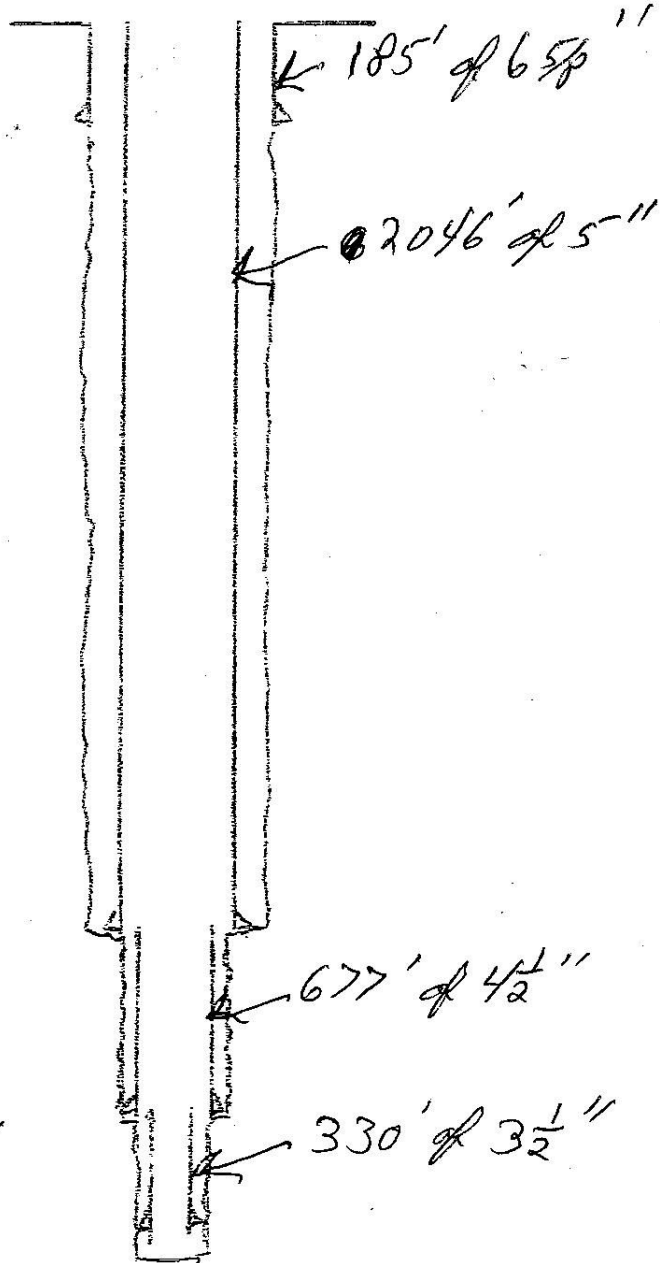

Total Depth 3020'