

## KERR-MCGEE OIL AND GAS ONSHORE LP

LEONA #1

NW SW 23 1N 67W 1,980' FSL 660' FWL

WELD,COLORADO

09/17/2014


AREA: ROUTE: Spud: 11/23/1981 WINS No.: H8024 AFE/WO#: 2098001 API#: 0512310475

GL: 4964 KB: 4975 MTD: 7750 TVD: 7750 LOG MD: 7752 PBMD: 7729 PBTVD: 7729

Directions:



<u>HOLE SECTIONS</u>		<u>Size</u>	<u>Top</u>	<u>Btm</u>	<u>TD Date</u>				
SURFACE		12.25	11	242	11/23/1981				
PRODUCTION		7.88	242	7752	12/01/1981				
<u>TUBULARS</u>	<u>Tool Type</u>	<u>Joints</u>	<u>Size</u>	<u>Weight</u>	<u>Grade</u>	<u>Thread</u>	<u>Top D</u>	<u>Bottom D</u>	
SURFACE CASING		Casing	6	8.63		K-55	ST&C	11	242
PRODUCTION CASING		Casing	43	4.50	11.60	K-55	ST&C	6500	7729
		Casing Float Collar	1	4.50				7729	7730
		Shoe Joint	1	4.50	11.60	K-55	ST&C	7730	7749
		Casing Guide Shoe	1	4.50				7749	7750
SAND PLUG		Sand Plug	1	4.50				7600	7729
<u>CEMENT JOBS</u>	<u>Stage</u>	<u>Sacks</u>	<u>Cement Jobs</u>			<u>Top D</u>	<u>Btm D</u>	<u>cbl</u>	
SURFACE CASING		PRIM CMT 1ST STAGE	200		REGULAR	11	242	No	
PRODUCTION CASING		PRIM CMT 1ST STAGE	175		50/50 POZ-MIX	7075	7750	No	
--None--		ABANDONMENT PLUC	10		REGULAR	11	40	No	
		ABANDONMENT PLUC	35		REGULAR	190	270	No	
		ABANDONMENT PLUC	35		REGULAR	710	760	No	
<u>PERFORATIONS</u>									
<u>Formation</u>	<u>Zone</u>	<u>Top</u>	<u>Btm</u>	<u>Date</u>	<u>Reason</u>	<u>Comments</u>			
CODELL		7614	7620	12/17/1981	PRODUCTION	Behind cmt capped sand plug			

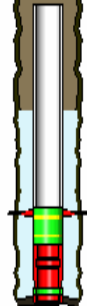

Comments: