


14'
42' 0

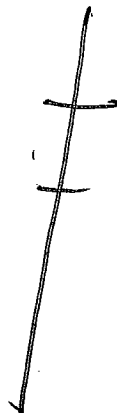

Kiser 3-13

N

A:\REGULATORY\Spill_Leak Internal Form_Blain