



June 30, 2015

Mr. Matt Lepore, Director
Colorado Oil and Gas Conservation Commission
The Chancery Building
1120 Lincoln Street, Suite 801
Denver, CO 80203

RE: Anschutz State 5-62-35-6457C2B
Township 5 North, Range 62 West, 6th P.M.
Section 35: NWSW (surface location)
Weld County, Colorado

Proposed Wellbore Unit (Containing 722.67 Acres, more or less):

Township 5 North, Range 62 West, 6th P.M.
Section 35: S2S2
Section 36: S2S2
Township 4 North, Range 62 West, 6th P.M.
Section 1: Lots 2-4
Section 2: Lots 1 and 2
Township 4 North, Range 61 West, 6th P.M.
Section 6: Lot 4

Dear Mr. Lepore:

Bill Barrett Corporation ("BBC") is planning to drill the captioned boundary well in accordance with the provisions of COGCC 318A.e.

BBC's wellbore spacing unit consists of section 26-S2S2, section 25-S2S2, section 35-N2N2, section 36-N2N2 of T5N-62W, creating the above referenced spacing unit in which we will target the Niobrara formation. I certify that all of the owners within the proposed wellbore spacing unit were noticed and no objections were received.

Enclosed is a copy of the following document to assist you in your review and approval of BBC's proposed changes for the captioned well.

- Plat illustrating the proposed wellbore spacing unit on existing location plat

Thank you for your attention to the enclosed. BBC respectfully requests that the COGCC review the enclosed information and approve the proposed changes for the captioned well.

Sincerely,

A handwritten signature in blue ink, appearing to read 'Mary Pobuda'.

Mary Pobuda
Permit Analyst

1099 18th Street, Suite 2300
Denver, CO 80202
P 303.293.9100
F 303.291.0420

T5N, R62W, 6th P.M.

BILL BARRETT CORPORATION

ANSCHUTZ STATE 5-62-35 36 NWSW PAD
 #5-62-35-6457C2B
 NW 1/4 SW 1/4, SECTION 35, T5N, R62W, 6th P.M.
 WELD COUNTY, COLORADO



BASIS OF BEARINGS
 BASIS OF BEARINGS IS A G.P.S. OBSERVATION
 BASIS OF ELEVATION

SPOT ELEVATION LOCATED AT THE NORTHEAST CORNER OF SECTION 24, T5N, R62W, 6th. P.M. TAKEN FROM THE POINT OF ROCKS, QUADRANGLE, COLORADO, WELD COUNTY, 7.5 MINUTE QUAD (TOPOGRAPHIC MAP) PUBLISHED BY THE UNITED STATES DEPARTMENT OF THE INTERIOR, GEOLOGICAL SURVEY. SAID ELEVATION IS MARKED AS BEING 4530 FEET.



2011 Alum. Cap,
 Flush W/Ground
 Lat: 40.363653°
 Long: 104.300061°

1974 Brass Cap
 1.0 Above Ground
 Lat: 40.363992°
 Long: 104.280594°

1974 Brass Cap
 Lat: 40.364336°
 Long: 104.261575°

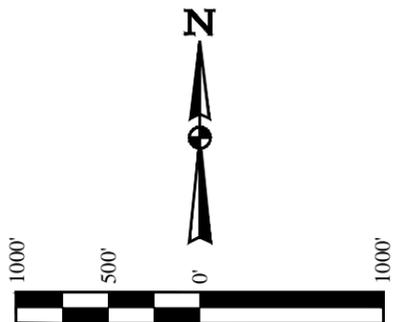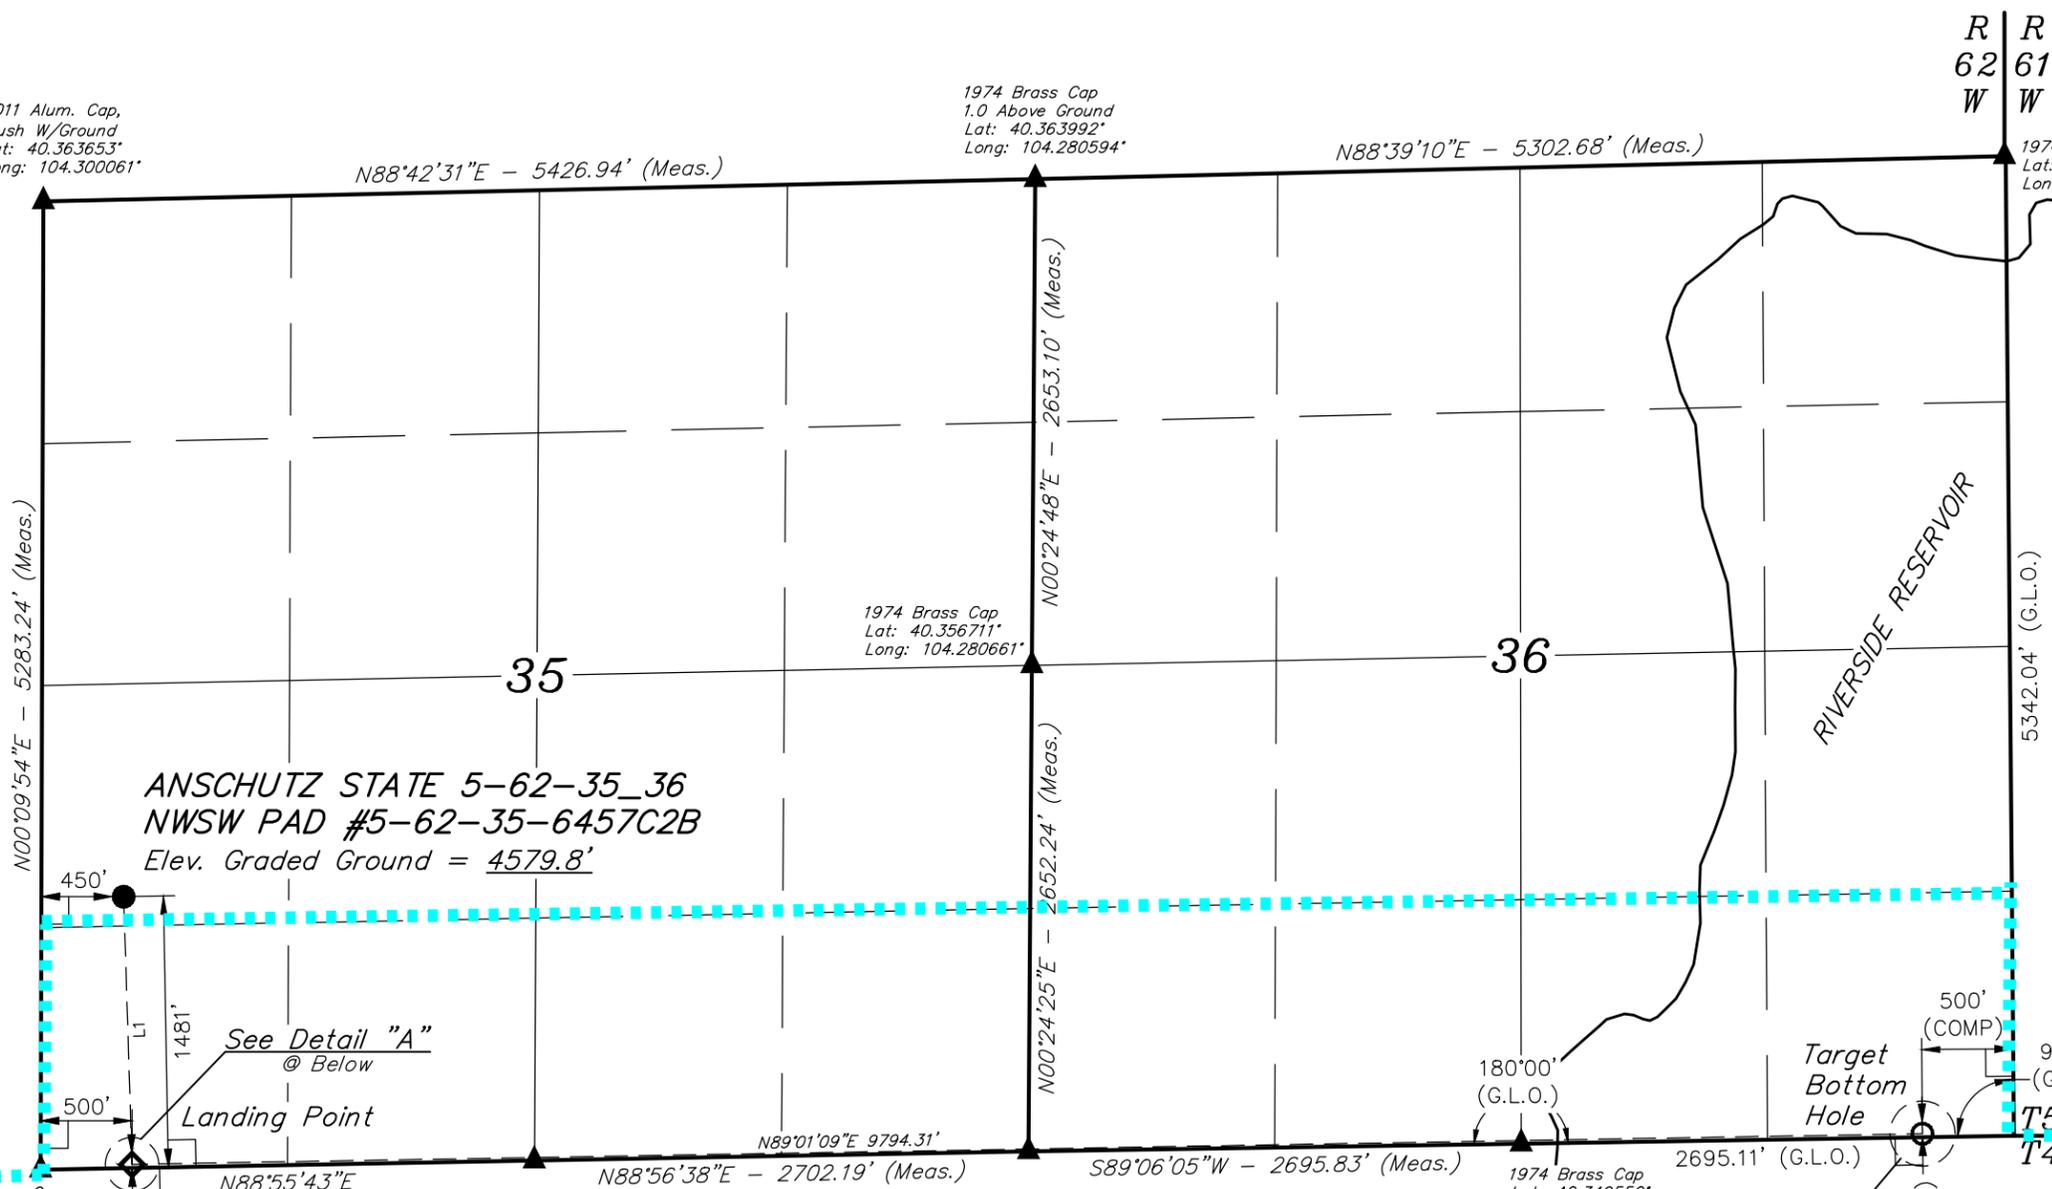

LINE TABLE		
LINE	DIRECTION	LENGTH
L1	S01°47'59"E	1461.37'

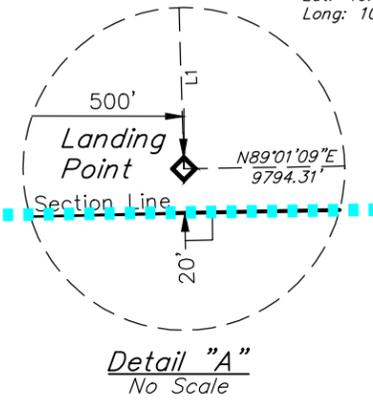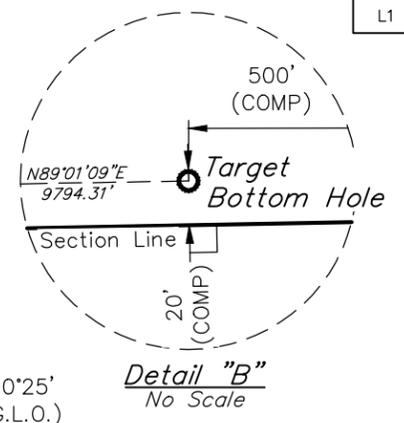

CERTIFICATE
 THIS IS TO CERTIFY THAT THE ABOVE PLAT WAS PREPARED FROM FIELD NOTES OF ACTUAL SURVEYS MADE BY ME OR UNDER MY SUPERVISION AND THAT THE SAME ARE TRUE AND CORRECT TO THE BEST OF MY KNOWLEDGE AND BELIEF.

[Signature]
 REGISTERED LAND SURVEYOR
 REGISTRATION NO. 28285
 STATE OF COLORADO
 PROFESSIONAL LAND SURVEYOR #15-15

- LEGEND:
- = 90° SYMBOL
 - = PROPOSED WELLHEAD.
 - = TARGET BOTTOM HOLE.
 - ◇ = LANDING POINT
 - ▲ = SECTION CORNERS LOCATED.

NAD 83 (TARGET BOTTOM HOLE)	NAD 83 (LANDING POINT)	NAD 83 (SURFACE LOCATION)
LATITUDE = 40°20'58.92" (40.349700)	LATITUDE = 40°20'57.24" (40.349233)	LATITUDE = 40°21'11.67" (40.353242)
LONGITUDE = 104°15'47.47" (104.263186)	LONGITUDE = 104°17'53.93" (104.298314)	LONGITUDE = 104°17'54.53" (104.298481)
NAD 27 (TARGET BOTTOM HOLE)	NAD 27 (LANDING POINT)	NAD 27 (SURFACE LOCATION)
LATITUDE = 40°20'58.99" (40.349719)	LATITUDE = 40°20'57.31" (40.349253)	LATITUDE = 40°21'11.74" (40.353261)
LONGITUDE = 104°15'45.65" (104.262681)	LONGITUDE = 104°17'52.10" (104.297806)	LONGITUDE = 104°17'52.70" (104.297972)
STATE PLANE NAD 83 (COLORADO NORTH)	STATE PLANE NAD 83 (COLORADO NORTH)	STATE PLANE NAD 83 (COLORADO NORTH)
N: 1372640.19 E: 3344709.78	N: 1372335.88 E: 3334922.76	N: 1373795.37 E: 3334856.49
STATE PLANE NAD 27 (COLORADO NORTH)	STATE PLANE NAD 27 (COLORADO NORTH)	STATE PLANE NAD 27 (COLORADO NORTH)
N: 372642.29 E: 2344859.90	N: 372337.96 E: 2335072.86	N: 373797.40 E: 2335006.58

PDOP = 1.4

UINTAH
 ENGINEERING & LAND SURVEYING

UELS, LLC
 Corporate Office * 85 South 200 East
 Vernal, UT 84078 * (435) 789-1017

SURVEYED BY: DALLAS NIELSEN, L.P.	DATE: 07-07-14
DRAWN BY: J.W.	DATE DRAWN: 05-01-14
SCALE: 1" = 1000'	REVISED: 03-30-15 K.B.

WELL LOCATION PLAT



Anschutz State 5-62-35-6457C2B

NWSW Sec. 35 T5N-R62W, 6th P.M.

SHL: 1481' FSL & 450' FWL

BHL: 1' FSL & 500' FEL

Proposed Wellbore Unit (Containing 722.67 Acres, more or less):

Township 5 North, Range 62 West, 6th P.M.

Section 35: S2S2

Section 36: S2S2

Township 4 North, Range 62 West, 6th P.M.

Section 1: Lots 2-4

Section 2: Lots 1 and 2

Township 4 North, Range 61 West, 6th P.M.

Section 6: Lot 4