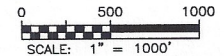
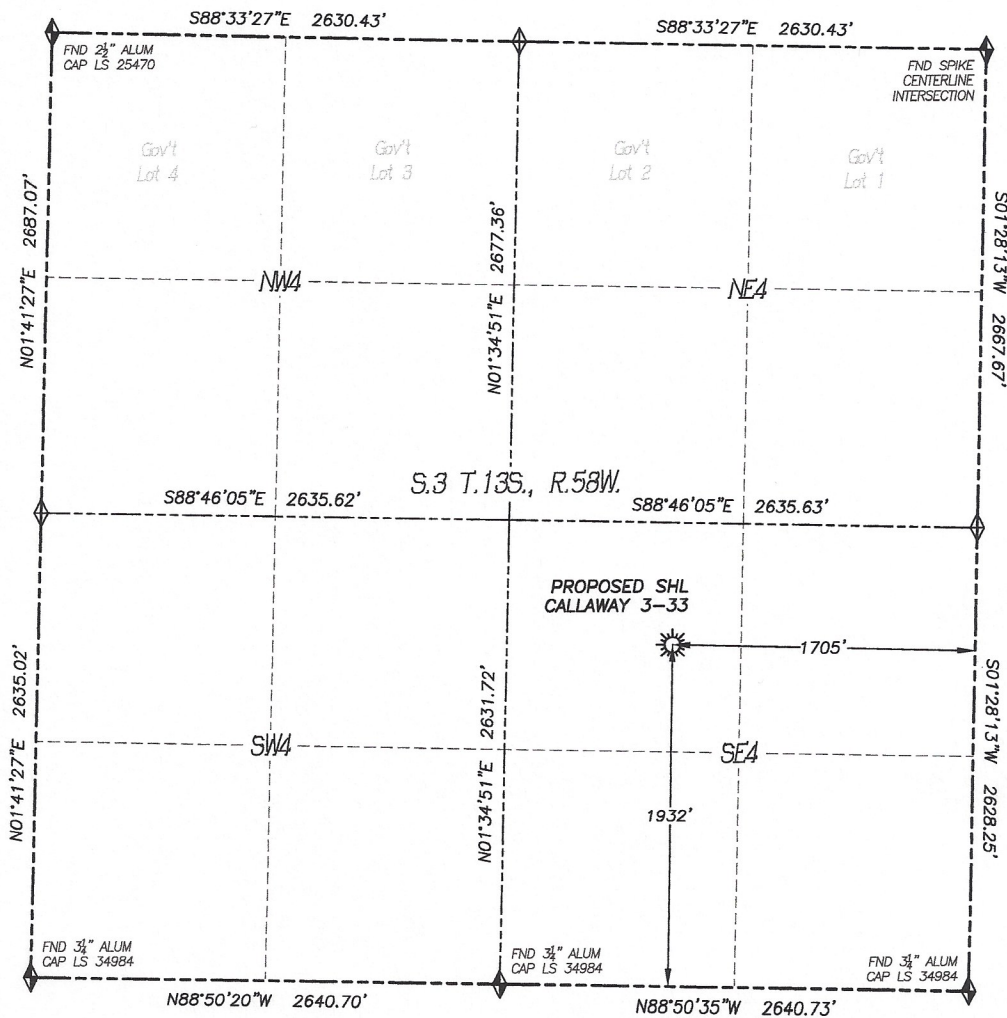


WELL LOCATION CERTIFICATE
CALLAWAY 3-33SECTION: 3
TOWNSHIP: 13S
RANGE: 58W

LEGEND

- ◆ FOUND MONUMENT AS DESCRIBED
- ☼ PROPOSED WELL
- ⊙ EXISTING WELL
- BOTTOM HOLE
- ◇ ABANDONED WELL
- ◇ CALCULATED POSITION

IN ACCORDANCE WITH A REQUEST FROM MUSTANG CREEK OPERATING, LLC., DALEY LAND SURVEYING, INC. HAS DETERMINED THE SURFACE LOCATION OF THE CALLAWAY 3-33 WELL TO BE 1932' FSL, 1705' FEL, AS MEASURED AT NINETY (90) DEGREES FROM THE SECTION LINES OF SECTION 3, TOWNSHIP 13 SOUTH, RANGE 58 WEST, OF THE 6TH PRINCIPAL MERIDIAN, ELBERT COUNTY, COLORADO.

I HEREBY STATE THAT THIS WELL LOCATION CERTIFICATE WAS PREPARED BY ME OR UNDER MY DIRECT SUPERVISION, THAT THE WORK WAS COMPLETED ON 6/17/2015 FOR AND ON BEHALF OF MUSTANG CREEK OPERATING, LLC., AND THAT THIS MAP DOES NOT REPRESENT A BOUNDARY SURVEY, IT IS NOT A LAND SURVEY PLAT OR AN IMPROVEMENT SURVEY PLAT AND IT IS NOT TO BE RELIED UPON FOR THE ESTABLISHMENT OF FENCE, BUILDING OR OTHER FUTURE IMPROVEMENT LINES.


NOTES:

- 1) BEARINGS FOR THIS MAP ARE ASSUMED AND BASED UPON GPS OBSERVATIONS MADE BETWEEN MONUMENTS LOCATED AT THE SOUTHEAST CORNER AND SOUTH QUARTER CORNER OF SECTION 3, T.13S., R.58W.
- 2) HORIZONTAL DATUM IS NAD83.
- 3) VERTICAL DATUM IS NAVD88 AND ORIGINATES FROM THE LOCAL C.O.R.S. NETWORK, UTILIZING THE GEOID12A MODEL.
- 4) SEE LOCATION DRAWING FOR VISIBLE IMPROVEMENTS WITHIN 500' OF PROPOSED DISTURBED AREA.
- 5) SURFACE USE: RANGELAND.
- 6) INST. OPERATOR: SCOTT ESTABROOKS.

NEAREST CULTURAL ITEMS:

- | | |
|--------------------------------|-----------|
| 1) BUILDING: | 2570'± NE |
| 2) BUILDING UNIT: | 3140'± N |
| 3) HIGH OCC. BLD. UNIT: | 5280'± |
| 4) DES. OUTSIDE ACTIVITY AREA: | 5280'± |
| 5) PUBLIC ROAD: | 1694'± E |
| 6) ABOVE GROUND UTILITY: | 3090'± NE |
| 7) RAILROAD: | 5280'± |
| 8) PROPERTY LINE: | 690'± N |

NAD 83		NAD27	
SURFACE LOCATION:		SURFACE LOCATION:	
LATITUDE:	N38.94497°	LATITUDE:	N38.94498°
LONGITUDE:	W103.87433°	LONGITUDE:	W103.87382°
ELEV:	5733'		
PDOP:	1.5		
QTR/QTR:	NW4/SE4		

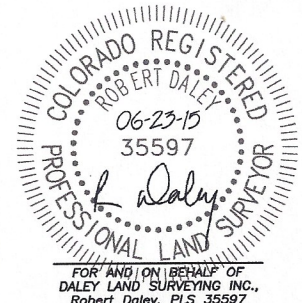



FOR AND ON BEHALF OF
DALEY LAND SURVEYING, INC.,
Robert Daley, PLS 35597

SHEET 1 OF 1

Drawing Date: 6/23/15

SITE SKETCH CALLAWAY 3-33

SECTION: 3
TOWNSHIP: 13S
RANGE: 58W

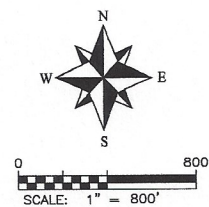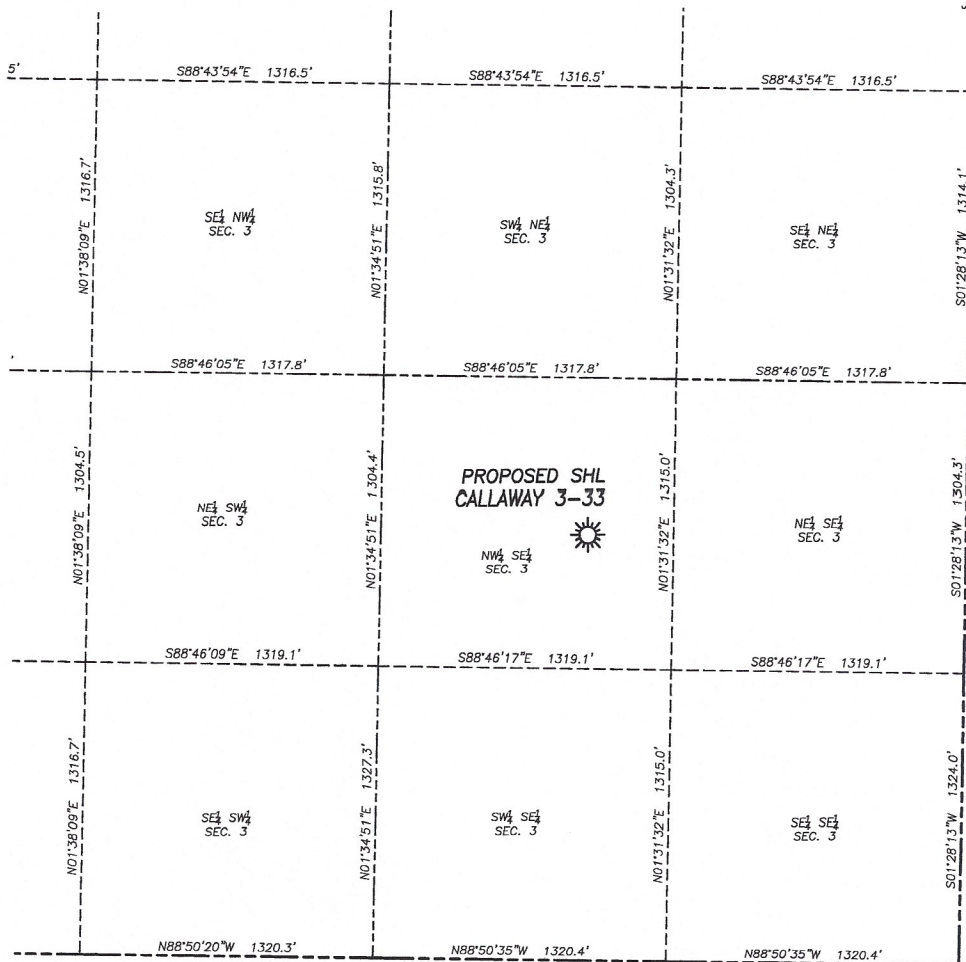

LEGEND

- FOUND MONUMENT
AS DESCRIBED
- PROPOSED WELL
- EXISTING WELL
- BOTTOM HOLE
- ABANDONED WELL
- CALCULATED POSITION