


Prepared By: Austin McCollum
Prepared Date: 6/22/2015

API #: 05-125-06749

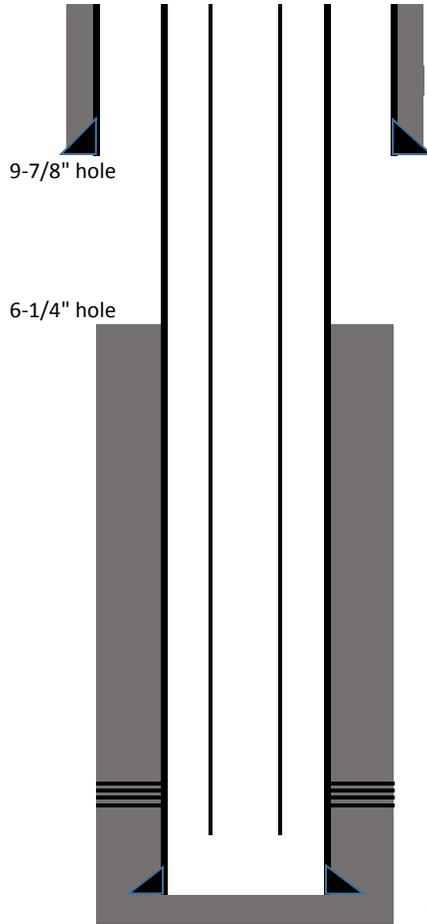

Open Perforations
1625' - 1640'

TD: 1790'

Surface Casing

7 in OD
17#
Set @ 282'
75 sx Cement
TOC: Surface

Production Casing

4.5 in OD
9.5#
Set @ 1756'
100 sx Cement
TOC: 723'

Tubing


55 jts. 2-3/8"
Set @ 1751'

Prepared By: Austin McCollum
Prepared Date: 6/22/2015

API #: 05-125-06749

Cement Used:
Class G Cement, 15.8#, 1.15 ft³/sack

Abandoned Perforations
1625' - 1640'

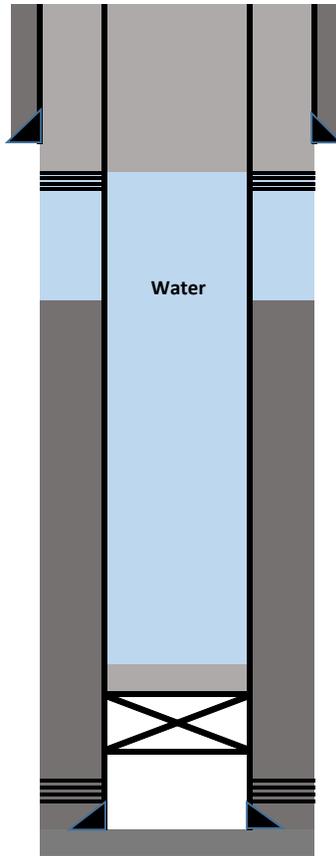

64 sx cement
From 350' to surface
inside 4-1/2 casing
and in annulus

Surface Casing
7 in OD
Set @ 282'
75 sx Cement
TOC: Surface
9-7/8" Hole

Production Casing
4.5 in OD
Set @ 1756'
100 sx Cement
TOC: 723'
6-1/4" Hole

26 BBLs of water in hole

CIPB set @ 1620'; 2 sx cement on top

TD: 1790'