


WHITING OIL & GAS CORP.
BOIES #4
SECTION 27, T2S, R98W, 6th P.M.

DATE: _____

DESCRIPTION:

[illegible]

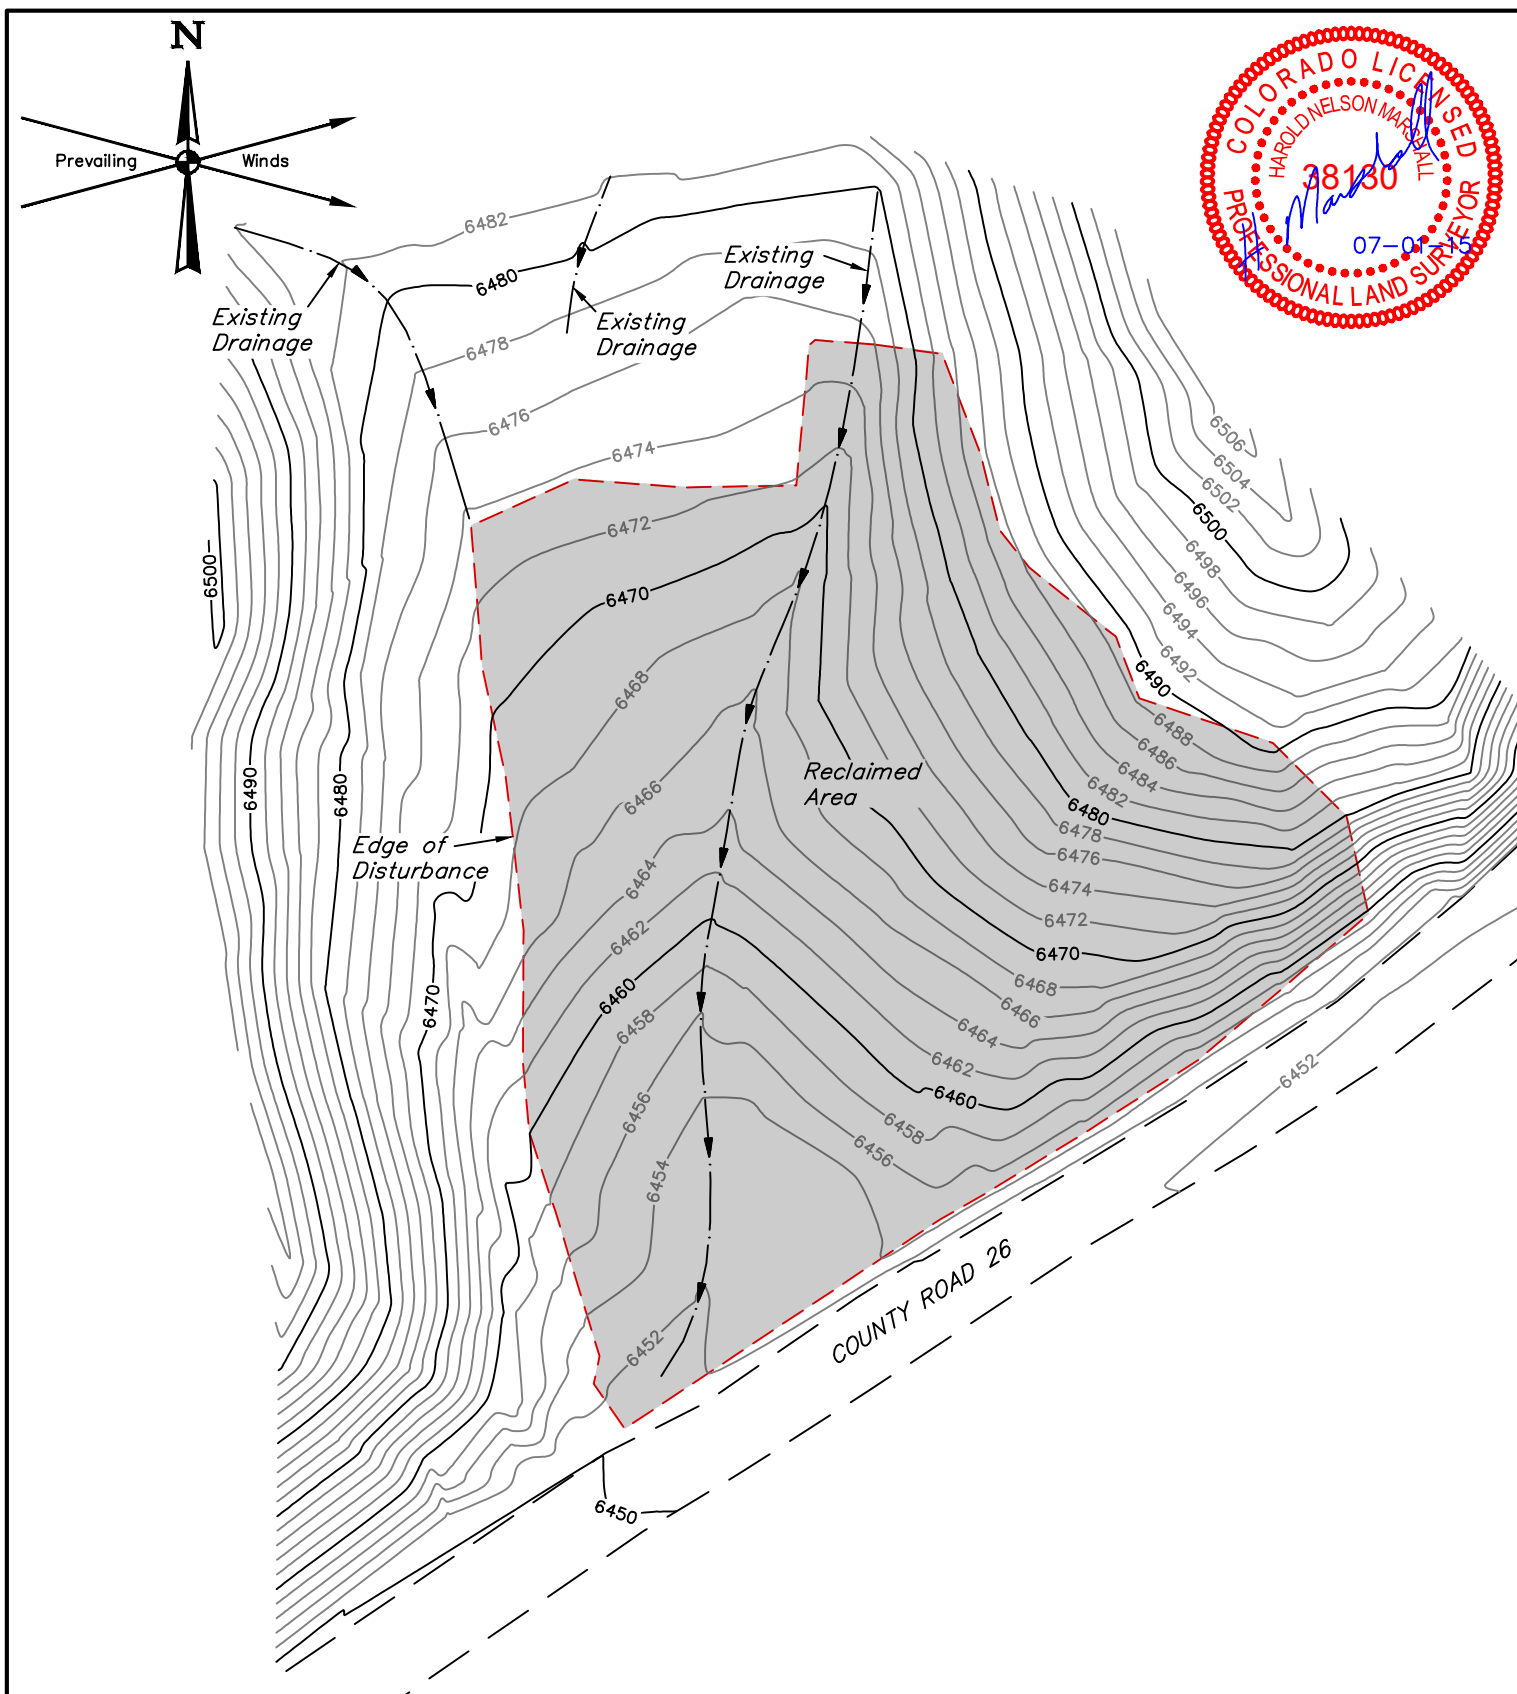

NOTES:

- Contours shown at 2' intervals.

WHITING OIL & GAS CORP.

BOIES #4
SW 1/4 NE 1/4, SECTION 27, T2S, R98W, 6th P.M.
RIO BLANCO COUNTY, COLORADO



UELS, LLC
 Corporate Office * 85 South 200 East
 Vernal, UT 84078 * (435) 789-1017

DRAWN BY: H.W.	DATE DRAWN: 07-01-15
SCALE: 1" = 60'	REVISED: 00-00-00
RECLAIMED SITE PLAN	