


CATAMOUNT ENERGY PARTNERS: ELSA 34-6-19 #1 & ELSA 34-6-19 #2
MULTIWELL TRAJECTORY DRAWING

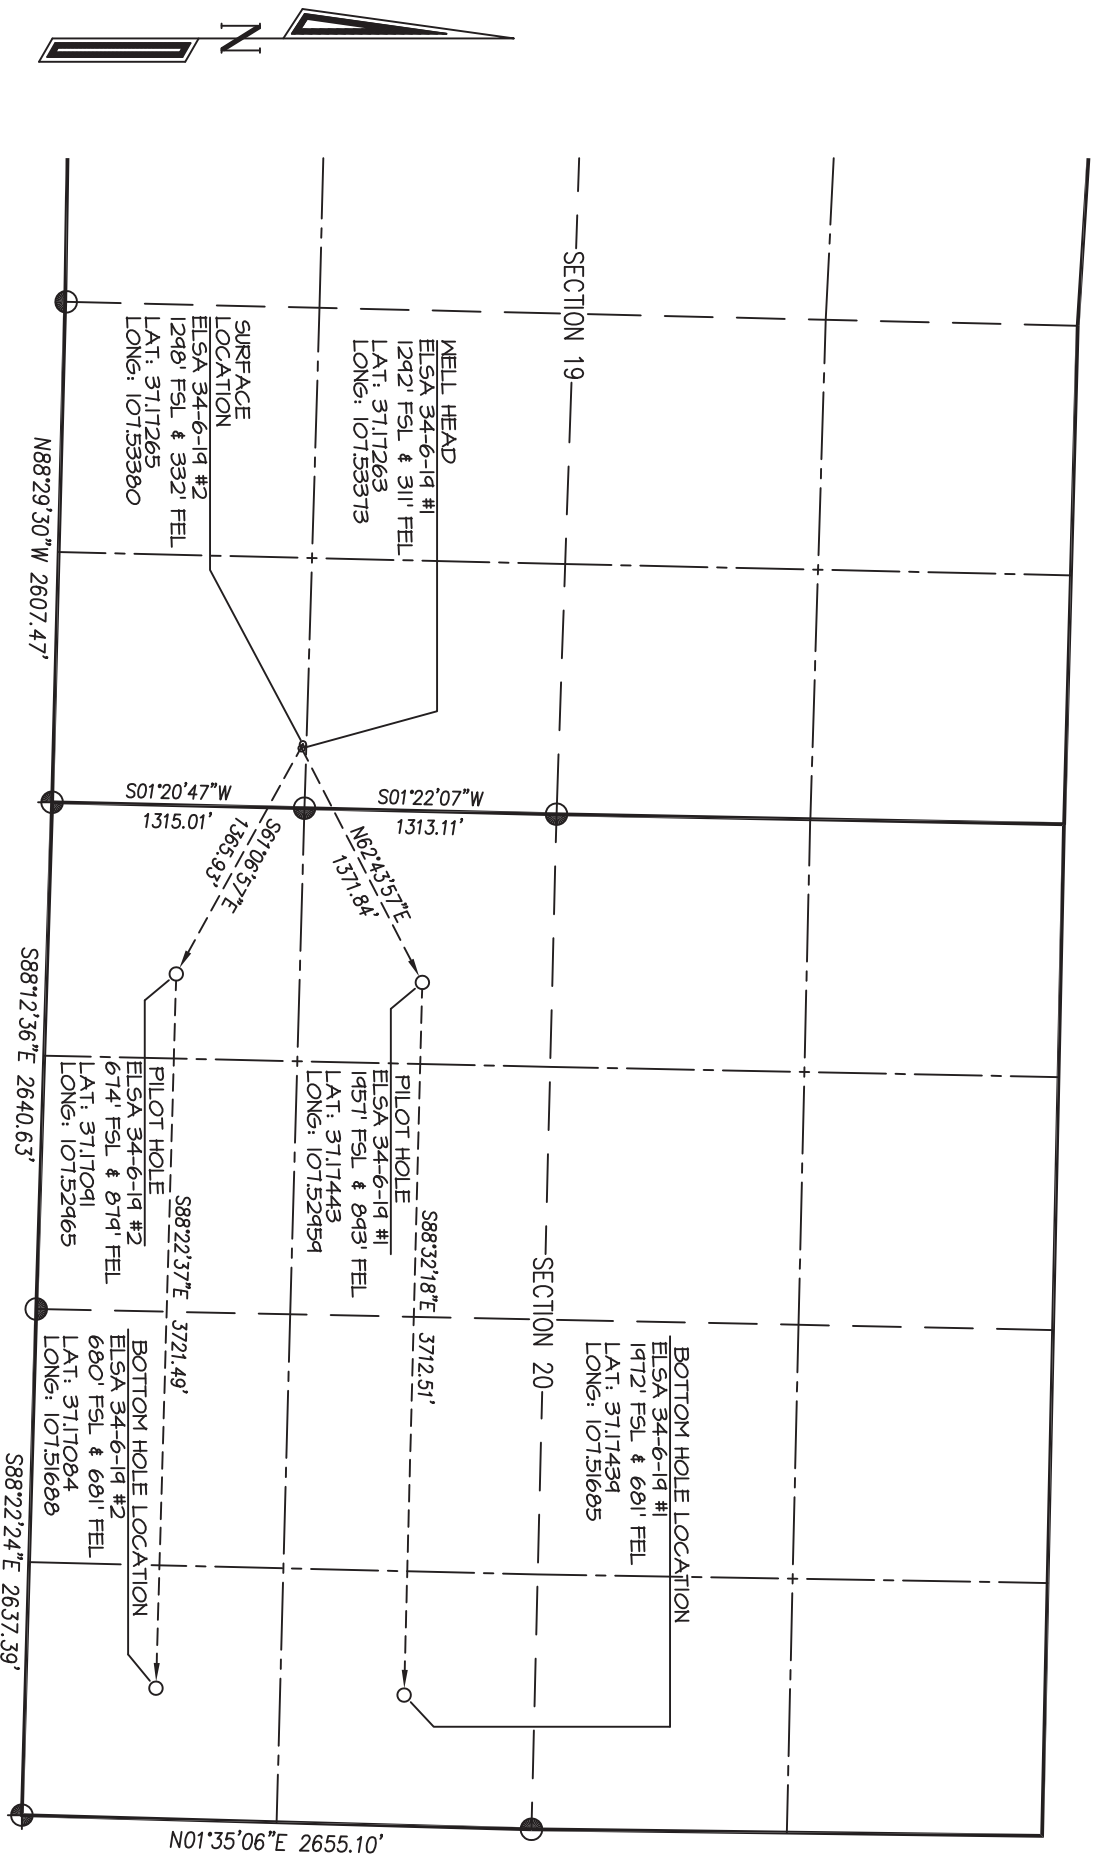

GRAPHIC SCALE 1"=1000'



LAT/LONG = NAD 83

SCALE: 1' = 1000'

DATE DRAWN: 5/22/15

NORTHSTAR SURVEYING & MAPPING, INC.

FILE NO. CM07MWP

DRAWN BY: K.R.

CHECKED BY: K.R.