

W&N

Amoco-Ewing #1 ARS

API # 05-123-01875

KB: 4,885'

TVD: 4,777'


Surface

8 5/8" 24 #/ft.

N-24

500 sk cement

12 1/4" hole

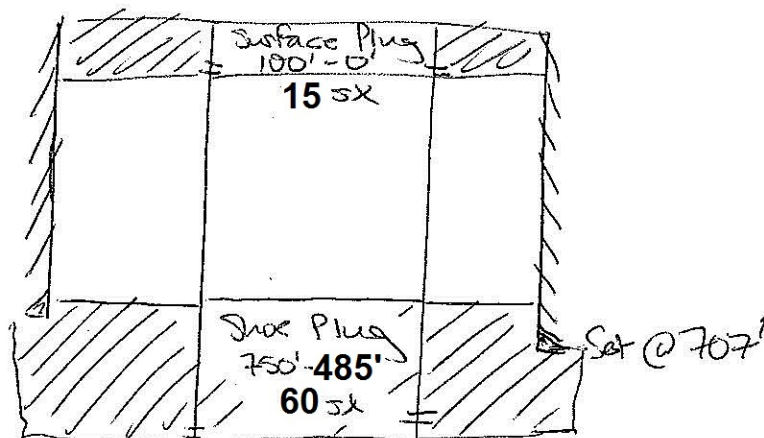

Set @ 707'

Production

4 1/2" 10.5 #/ft.

J-55

200 sk cement

7 7/8" hole

TAC CWC
3,855'

CIBP @
4,540'
w/ 2 sk cement

Perfs
4,590' - 4,600' 18 holes
4,624' - 4,630'
4,634' - 4,648'

Stimulation
80,000 gal XF46 gelled H₂O
200,000 # 10-70/20-40 sand

Set @ 4,774'

PBTD: 4,700'