





Lat40°, Inc. 6250 W. 10th Street, Unit 2, Greeley, CO 970-515-5294

# LOCATION DRAWING

ANTELOPE J-21 PAD

SECTION: 21  
TOWNSHIP: 5N  
RANGE: 62W  
6TH. P.M.  
WELD COUNTY, CO

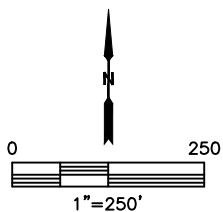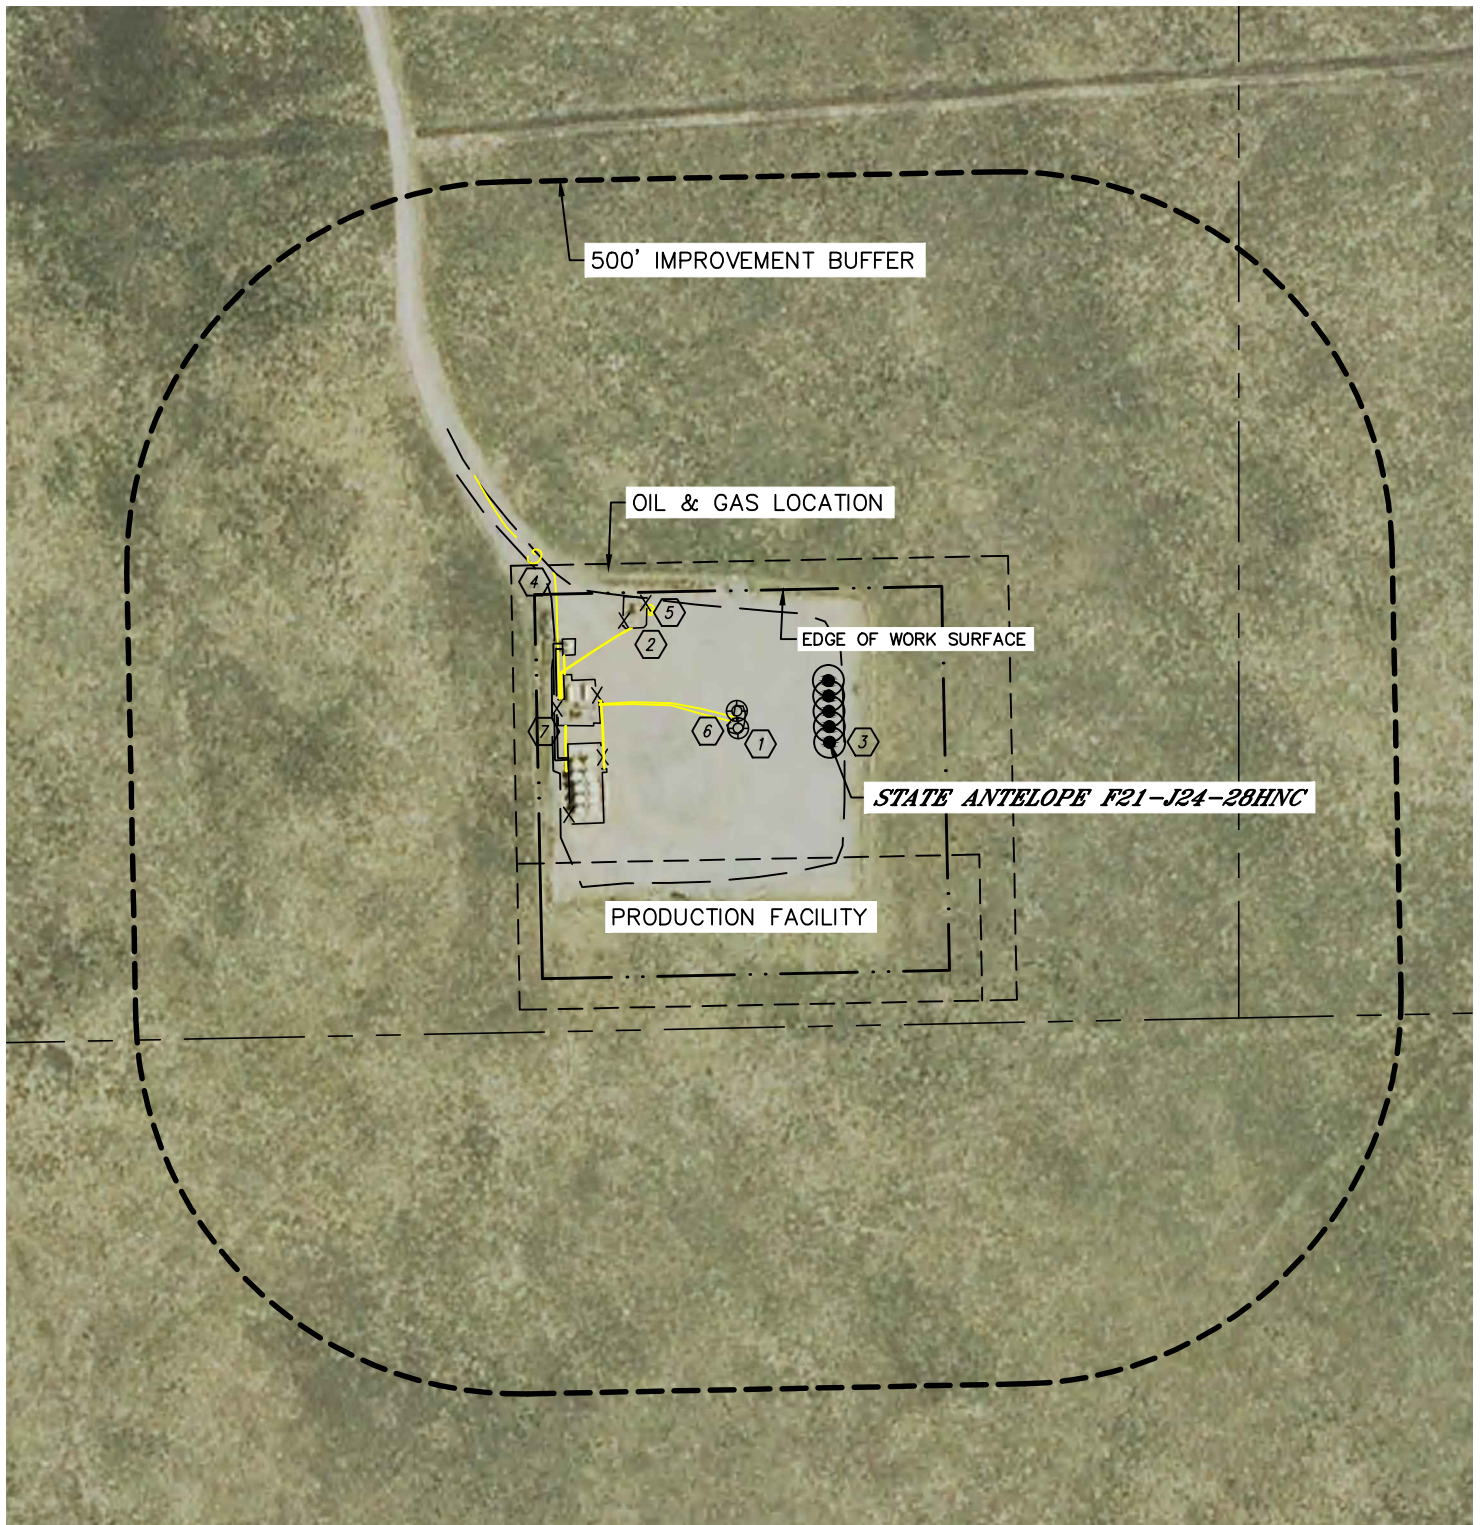



Lat40°, Inc. 6250 W. 10th Street, Unit 2, Greeley, CO 970-515-5294










## LOCATION DRAWING

ANTELOPE J-21 PAD

SECTION: 21  
TOWNSHIP: 5N  
RANGE: 62W  
6TH. P.M.  
WELD COUNTY, CO

### IMPROVEMENTS:

(MEASURED FROM THE PROPOSED STATE ANTELOPE F21-J24-28HNC WELL LOCATION)

-  NO BUILDING UNITS WITHIN 500' IMPROVEMENT BUFFER
-  NO BUILDINGS WITHIN 500' IMPROVEMENT BUFFER
-  EX. WELL HEAD 121' & 127' NW
-  EX. PRODUCTION EQUIPMENT (BCEI) 283', 300' & 350' NW, 291' W
-  EDGE OF GRAVEL 19' E
-  ROAD 405' NW
-  GAS VALVE 291' NW
-  GAS LOCATES (BCEI)  $\pm 129'$ ,  $\pm 131'$ ,  $\pm 298'$  &  $\pm 356'$  NW,  $\pm 294'$  &  $\pm 343'$  W
-  PIPE 341' W