


WPX ENERGY ROCKY MOUNTAIN LLC
Federal RU 444-7
Rulison Field
Section 7 T 7S-R93W

Formation Tops
 (Measured Depths)

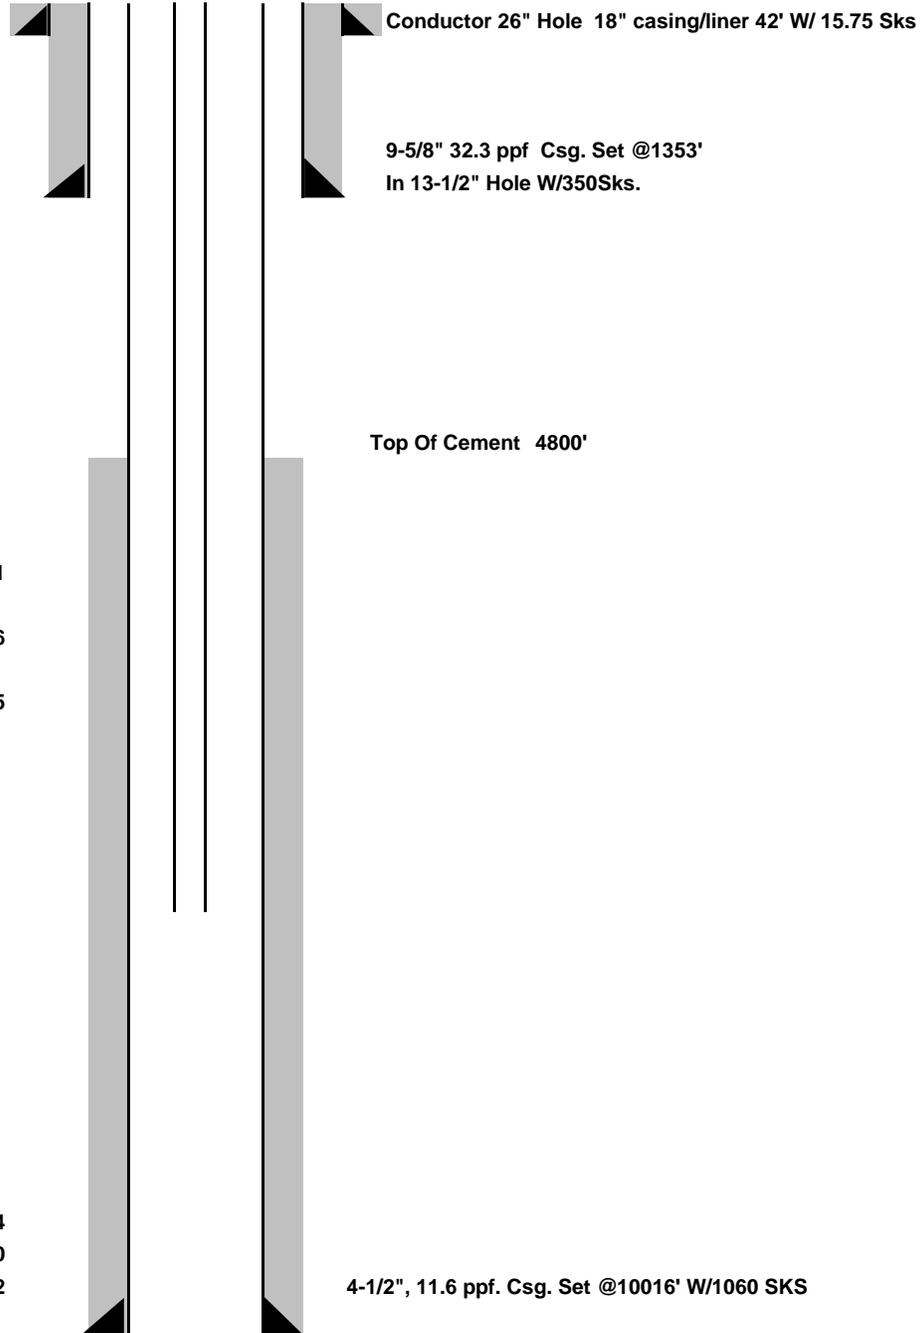

Tubing not set

PBTD @ 9984
 TMD @ 10030
 TVD @ 9992

4-1/2", 11.6 ppf. Csg. Set @10016' W/1060 SKS