


Catamount Energy Partners Carpenter 32-6-3#2 Lateral Wellbore Schematic

South

North

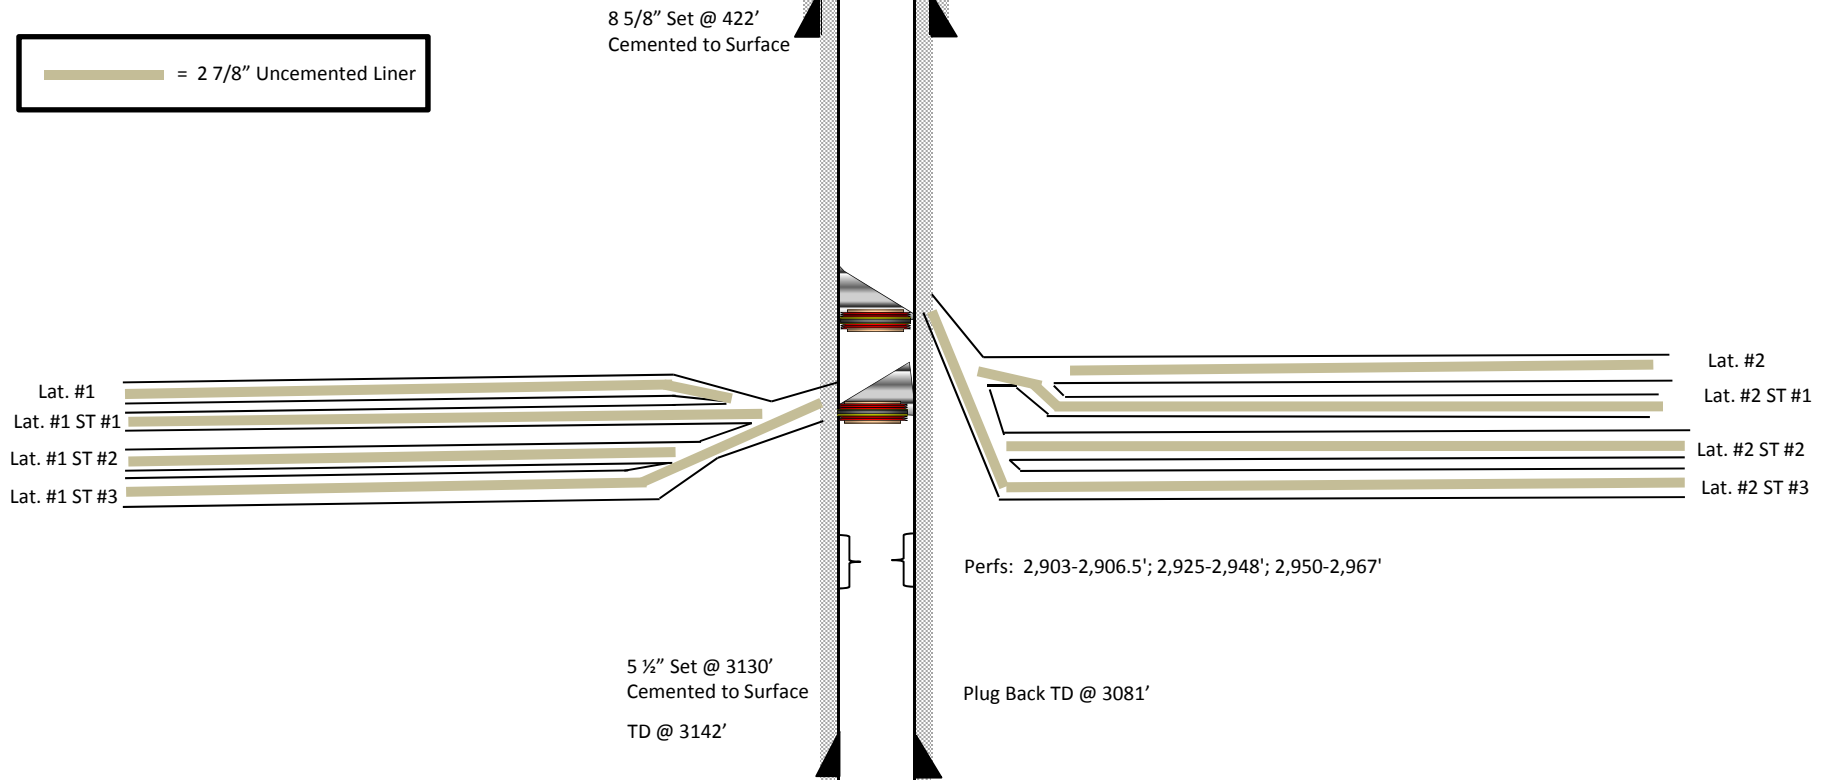

| Lateral Name | Drill Order | KOP (MD) | TD | Liner Bottom | Liner Top | Total Perforations | Hole Size | Catamount Coal Zone Name | API Extension | BHL | Notes |
|------------------|-------------|----------|------|--------------|-----------|--------------------|-----------|--------------------------|---------------|----------------------|-----------------------|
| Lateral #1 | 1 | 2741 | 4971 | 4969 | 3315 | 546 | .5" | Pargin | 0100 | 723' FSL & 717' FEL | Window 2732-2738' MD |
| Lateral #1 St #1 | 2 | 3181 | 4817 | 4814 | 3199 | 525 | .5" | Pargin | 0200 | 708' FSL & 1918' FEL | |
| Lateral #1 St #2 | 3 | 3088 | 4985 | 4980 | 3354 | 546 | .5" | Ignacio | 0300 | 696' FSL & 673' FEL | |
| Lateral #1 St #3 | 4 | 3276 | 4786 | 4781 | 2749 | 609 | .5" | Ignacio | 0400 | 701' FSL & 1937' FEL | |
| Lateral #2 | 5 | 2694 | 5151 | 5147 | 3559 | 525 | .5" | Pargin | 0500 | 693' FNL & 1932' FEL | Window 2685- 2691' MD |
| Lateral #2 St #1 | 6 | 3476 | 5384 | 5379 | 3279 | 693 | .5" | Pargin | 0600 | 797' FNL & 664' FEL | |
| Lateral #2 St #2 | 7 | 3178 | 5127 | 5122 | 3217 | 630 | .5" | Ignacio | 0700 | 695' FNL & 1966' FEL | |
| Lateral #2 St #3 | 8 | 3084 | 5491 | 5251 | 2701 | 777 | .5" | Ignacio | 0800 | 695' FNL & 689' FEL | |