


Note:
 The measurement for determining any Designated Setback Location shall be made from the center of the Well nearest any Building Unit to the nearest wall or corner of such Building Unit.

Building	-	690'
Building Unit	-	690'
HOB	-	1217'
DOAA	-	N/A
Public Road	-	506'
Above Grnd Util.	-	580'
Railroad	-	5280+
Property Line	-	265'

Current Surface Land Use:
 Gas Pad

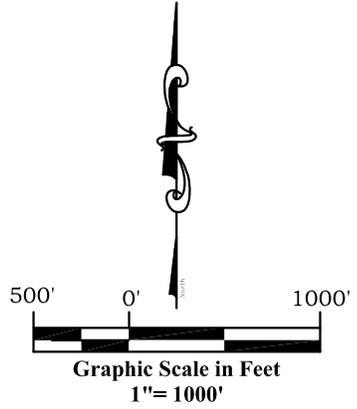

Legend

- ◊ - Field Surveyed Section Corner
- ◆ - Field Surveyed Quarter Corner
- ⊙ - Calculated Section Corner Location
- ⊕ - Field Surveyed 1/6 Corner

Surface:
MR 24A-18-07-95
 266' FSL
 824' FEL
 Gnd El= 5447
 Pad El= 5447
NAD83
 Lat: 39.431154646°N
 Long: 108.033244197°W

Notes:

1. LATITUDE AND LONGITUDE COORDINATES ARE DIFFERENTIALLY CORRECTED AND BASED ON PUBLISHED NGS CONTROL STATION "WDP-5". SYSTEM: UTM ZONE: 13 NORTH DATUM: NAD 1983 (CONUS)
2. ELEVATIONS ARE BASED ON NAVD OF 1929.
3. ALL BOTTOM AND TOP HOLE LOCATIONS ARE MEASURED 90 DEGREES FROM SECTION LINE.
4. USGS QUADRANGLE MAP "PARACHUTE".
5. CURRENT SURFACE LAND USE: GAS WELL PAD.
6. PDOP AT THE TIME OF LOCATION OF SURFACE WELL = 1.2

SURVEYOR'S CERTIFICATE

I, SCOTT E. AIBNER, A REGISTERED LAND SURVEYOR, LICENSED UNDER THE LAWS OF THE STATE OF COLORADO HEREBY CERTIFY THAT THE SURVEY SHOWN HEREON WAS PREPARED BY RIVER VALLEY SURVEY, INC. FOR URSA OPERATING COMPANY, LLC, BY ME OR UNDER MY DIRECT SUPERVISION AND THAT THIS PLAT IS A TRUE REPRESENTATION THEREOF.



BY: SCOTT E. AIBNER, COLORADO REG. NO. 31143

**Prepared For: Ursa Operating Company LLC
 As-Drilled Monument Ridge 24A-18-07-95 Well,
 Surface Situate in The SE 1/4 SE 1/4 Section 18,
 Township 7 South, Range 95 West of the 6 th.
 Principal Meridian, County of Garfield, State of
 Colorado.**



River Valley Survey, Inc.
 110 East 3rd. Street, Suite 213
 Rifle, Colorado 81650
 Ph: 970-379-7846

Project: RVS 06001-56	
Field Date: 03-04-14	Scale: 1"= 1000'
Date: 07-22-15	Sheet: 1 of 1

**303a Form 2 - As-Drilled
 Monument Ridge Pad
 Monument Ridge 24A-18-07-95
 Section 18, Township 7 South, Range 95 West**