API:	**05-123-10152**	**KB ELEVATION:**	**4805'**	**QTR-QTR:**	**NWSE**
WELL NAME:	**RUSCH 34-15**	**GROUND LEVEL:**	**4795'**	**SECTION:**	**15**
COUNTY:	**WELD**	**MD:**	**7106'**	**TWNSHIP:**	**3N**
LATITUDE:		**PBMD:**		**RANGE:**	**67W**
LONGITUDE:		**CREATED BY:**	**Reed Boeger**		
		DATE:	8/11/2015		**FINAL**

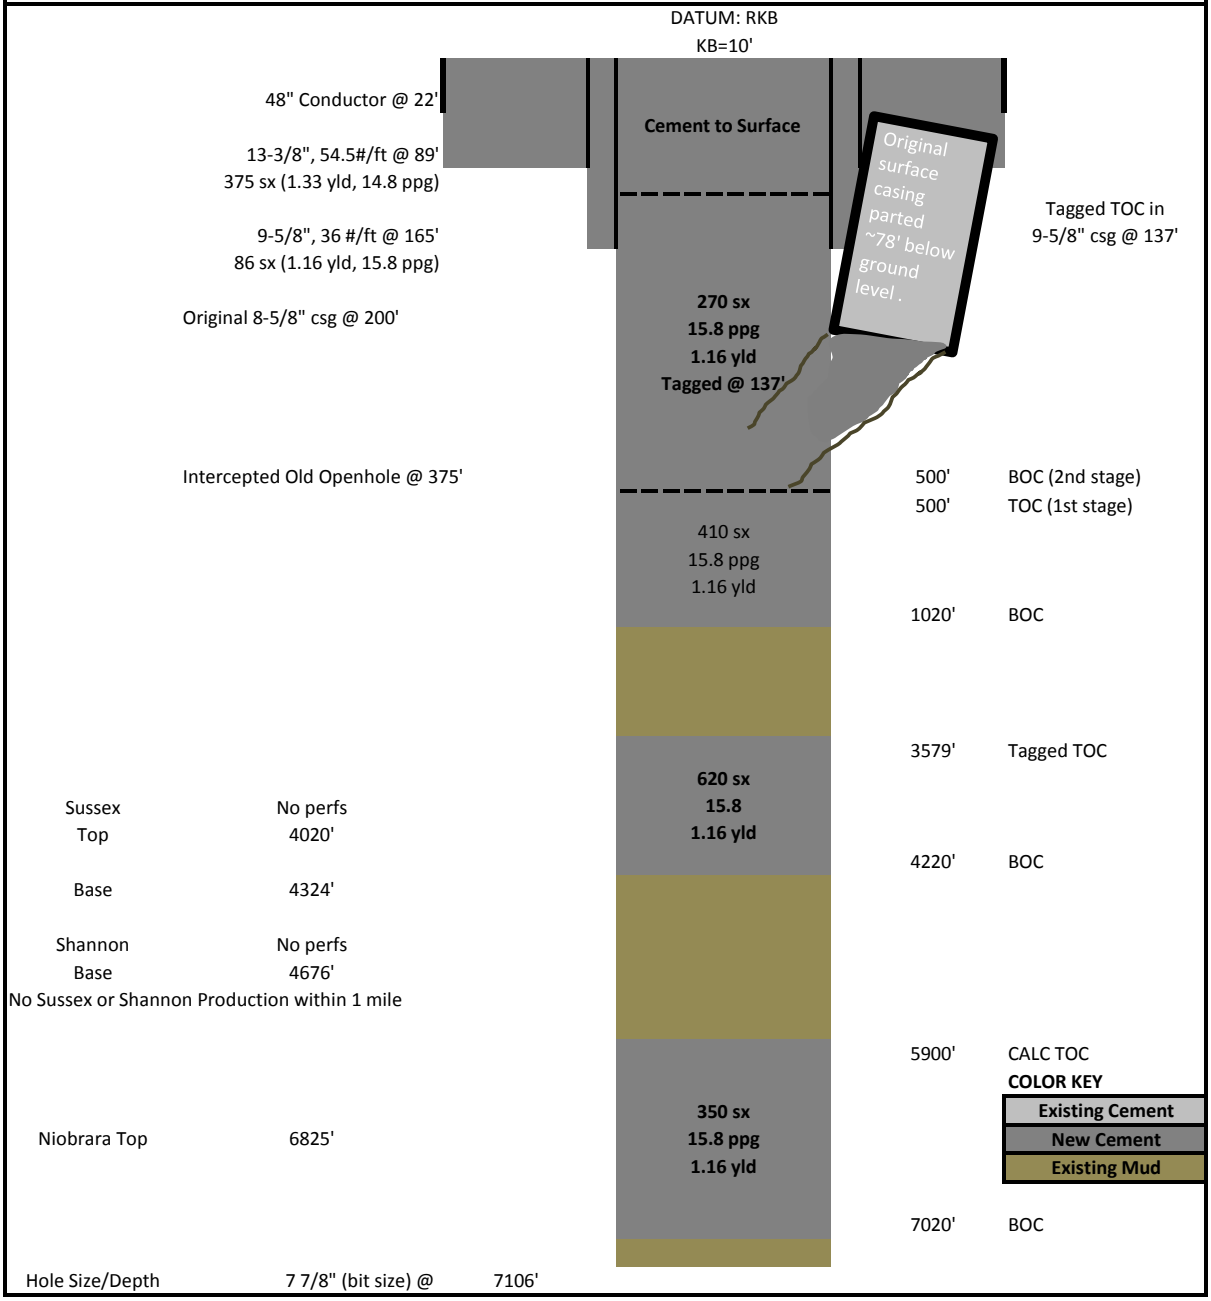

Sussex	No perfs	
Top	4020'	
Base	4324'	
Shannon	No perfs	
Base	4676'	

No Sussex or Shannon Production within 1 mile

Niobrara Top	6825'	
Hole Size/Depth	7 7/8" (bit size) @	7106'