

MARALEX RESOURCES, INC.

Plugged Wellbore

| | |
|------------------|---------------------------------------|
| WELL NAME | South Shale Ridge 3-20 |
| LOCATION | NENW Section 20 T8S R98W 6PM |
| GPS | 39.350469 -108.353371 PDOP 3.7 |
| API # | 05-077-08612 |

| | |
|---------------------|-------------------|
| FIELD | South Shale Ridge |
| COUNTY | Mesa |
| GPS OPERATOR | M. Nastal |
| FORMATION | Cameo Coal |

CASING

SURFACE

| | |
|------------------------|-------------------------------------|
| SIZE & WT | 8 ⁵ / ₈ " 24# |
| SET @ | 239' |
| HOLE SIZE | 12 ¹ / ₄ " |
| CEMENT | 220 sxs |
| Thixotropic w/ 2% CaCl | |
| TOC @ surface | |

PRODUCTION

| | |
|-------------|---------------------------------------|
| SIZE & WT | 4 ¹ / ₂ " 11.6# |
| SET @ | 4089' |
| HOLE SIZE | 7 ⁷ / ₈ " |
| CEMENT | 600 sxs Highbond 50 |
| w/ 2% CaCl | |
| TOC @ 1500' | |

STAGE TOOL


@ NA

PERFORATIONS

| | |
|----------|-------|
| Top | 3693' |
| Bottom | 3953' |
| 28 holes | |

FORMATION TOPS

| | |
|-------------|---------|
| Wasatch | surface |
| Mesa Verde | 1502' |
| Cameo Coals | 3674' |
| Rollins | 3955' |

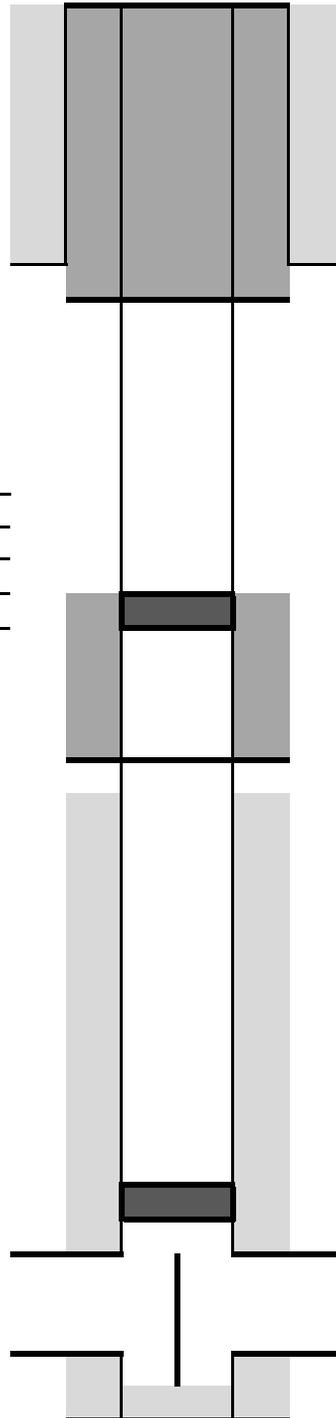

Casing strings cut-off 4' below GL

Steel plate w/ weep hole welded on casing stub

8⁵/₈" @ 239'

Squeeze perms @ 289'

75 sxs of cement - 4¹/₂" & 4¹/₂" X 8⁵/₈" annulus filled with cement

CICR @ 1350'

30 sxs of cement - 100' inside 4¹/₂" & 100' in annulus

Squeeze perms @ 1450'

CIBP @ 3600' w/ 2 sxs cement on top

Perforations 3693'-3953'
Top of 2³/₈" tubing fish
at 3713'

PBTD 4073'

4¹/₂" @ 4089'

TOTAL DEPTH 4105'