

## WELLBORE DIAGRAM

**Bayswater  
Robel 19-28**

NW SW 28-T7N-R64W

Hwy 85 north to WCR 74, east to WCR 53, N. To WCR 76,E.25, N. Into location  
North well of 3 wells

Updated  
11/8/2014  
Talkington


Weld, CO  
05-123-34201

G.L.= 4852  
K.B.= 4862  

---

10

TOC 750'

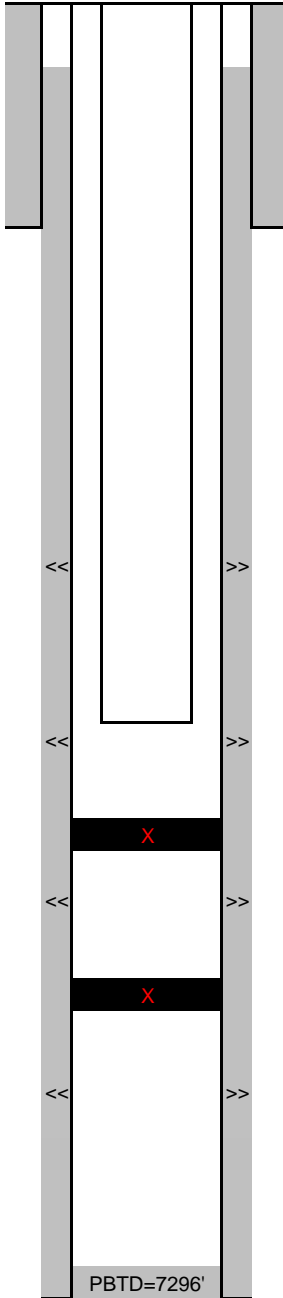

8-5/8" set at 769'  
Cmt't w/ 540 sx 15.2 ppg to Surf.

<< >> Nio A: 6834'-6844', 4 spf, 40 Holes (10/285/14)  
Frac 10/28/14 92,829 gals FR Fluid, 41,790 gals SLF, 24,450lbs. 30/50 White, 2,210 BLTR

**EOT @ 6,898' (11/8/14)**

<< >> Nio B: 6930'-6950' 4 spf, 80 Holes  
Frac 10/27/14 284,277 gals FR Fluid, 204,494 gals SLF, 136,192lbs. 30/50 White, 6,780 BLTR

**Set CIFP @ 6980' (10/27/14)**

<< >> Nio C: 7014'-7030', 4 spf, 64 Holes (10/26/14)  
Frac 10/27/14 160,568 gals FR Fluid, 133,049 gals SLF, 98,006 lbs 30/50 White, 3,871 BLTR

**Set CIBP @ 7070' (10/26/14)**

<< >> **Codell: 7104-7118', 4 spf, 56 holes**  
Frac 11/18/11: 213,990 gals FR water, 147,084 gals SLF, 150,400lbs 30/50 White

4.5" 11.6# N-80 CSG @ 7440' (7-7/8" O.H.)  
Cmt'd w/ 230 sx Prem Lite 11.0 ppg, 425 sx Prem Lite 12.5 ppg, 210 sx 50/50 Poz 14.6 ppg.