


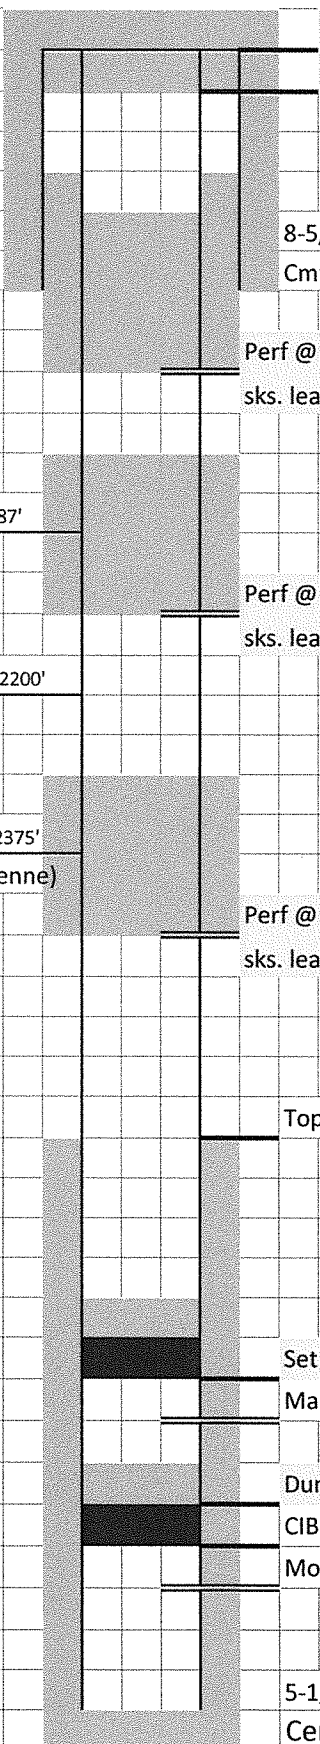

DRILLING COMPANY, INC. **WICHITA, KANSAS**

Current Wellbore Configuration

	Cut casing 5' below surface and weld cap on top	Date:	8/13/2015
	15 sk plug at surface	Well Name:	State-Hines #1-16
		Location:	SE SE 16-T13S-R47W
	8-5/8", 24# set at 350'	County:	Cheyenne
	Cmt to surf w/225 sx.	State:	Colorado
		API:	05-017-06568
	Perf @ 400' & squeeze with 100	KB:	4380'
	sks. leaving 100' in casing	GL:	4369'
		Spud Date:	9/26/1985
	Top Dakota @ 1887'		
	Perf @ 1937' & squeeze with 100		
	sks. leaving 100' in casing		
Top Cheyenne @ 2200'			
Top Morrison @ 2375'			
(Base of Cheyenne)			
	Perf @ 2425' & squeeze with 100		
	sks. leaving 100' in casing		
	Top of Cement at 4216' (CBL dated 10/12/85)		
	Set CIBP at 4850' w/2 sks. cement on top		
	Marmaton Perforations at 4875'-4894' (42 holes)		
	Dump 2 sks. cement on top of CIBP		
	CIBP set at 4930'		
	Morrow Sand Perfs at 5414'-5417' (10 holes)		
	5-1/2", 17# csg set at 5558'		
	Cemnted with 175 sks. 50/50 Pozmix		