




Lat40°, Inc. 6250 W. 10th Street, Unit 2, Greeley, CO 970-515-5294

AS-DRILLED WELL LOCATION CERTIFICATE

PRONGHORN O24-15-10XRLNB

SECTION: 15
TOWNSHIP: 5N
RANGE: 61W
6TH. P.M.
WELD COUNTY, CO

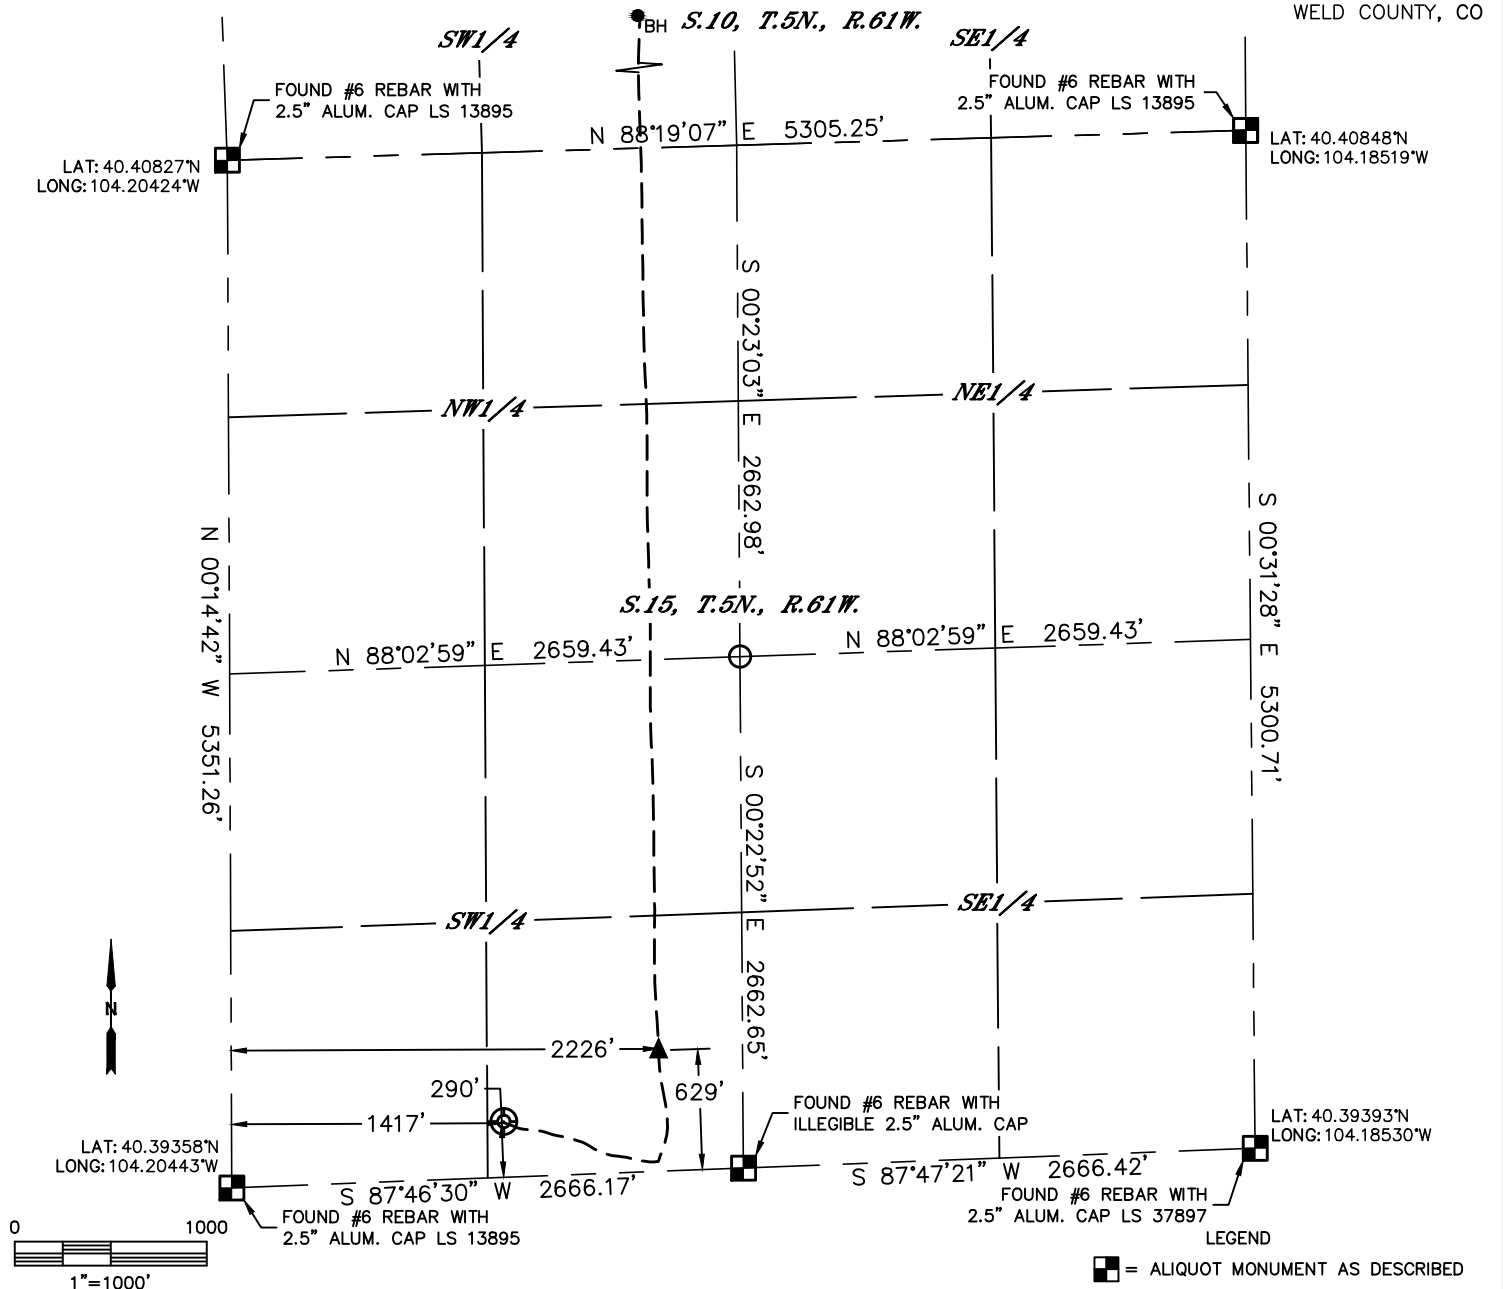


CLIENT: BONANAZA CREEK ENERGY				LANDMAN: KEITH CAPLAN			
INSTRUMENT OPERATOR: ADAM BEAUPREZ				SURVEY DATE: 04/21/2015		SURFACE USE: RANGELAND	
SHL FOOTAGE	SHL LAT °	SHL LONG °	PDOP	ELEV (FT.)	1/4/1/4	SHL S-T-R	
290 FSL 1417 FWL	40.39447	-104.19933	1.5	4669	SESW	15-5-61	

BHL FOOTAGE	BHL LAT °	BHL LONG °	BHL S-T-R	7" CP LAT °	7" CP LONG °	7" CP S-T-R
453 FNL 2246 FWL	40.42181	-104.19657	10-5-61	40.39546	-104.19642	15-5-61

NEAREST CULTURAL ITEMS	
BUILDING	5280'+
BUILDING UNIT	5280'+
HIGH OCCUPANCY BUILDING UNIT	5280'+
DESIGNATED OUTSIDE ACTIVITY AREA	5280'+
PUBLIC ROAD	5280'+
ABOVE GROUND UTILITY	5280'+
RAILROAD	5280'+
PROPERTY LINE	±290'S

NOTE:

- Bearings shown are Grid Bearings of the Colorado State Plane Coordinate System, North Zone, North American Datum 1983. The lineal dimensions as contained herein are based upon the "U.S. Survey Foot."
- Distance to section lines measured at right angles
- Ground elevations are based on an observed GPS elevation (NAVD 1988 DATUM).
- Latitude and Longitude shown are (NAD 83 DATUM).
- IMPROVEMENTS: See LOCATION DRAWING for all visible improvements within 500' of disturbed area.
- This map does not represent a boundary survey

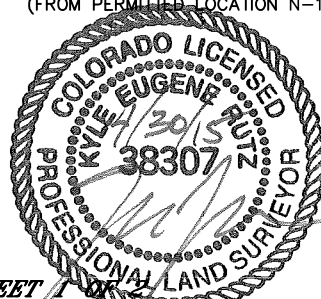



SHEET 1 OF 1
Kyle E. Rutz—On behalf of Lat40°, Inc.
Colorado Licensed Professional Land Surveyor No. 38307
DATE: 04/30/2015
PROJECT#: 2012073

Lat40°, Inc. 6250 W. 10th Street, Unit 2, Greeley, CO 970-515-5294






AS-DRILLED WELL LOCATION CERTIFICATE

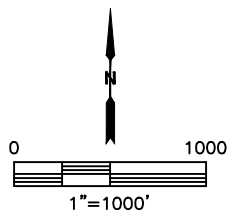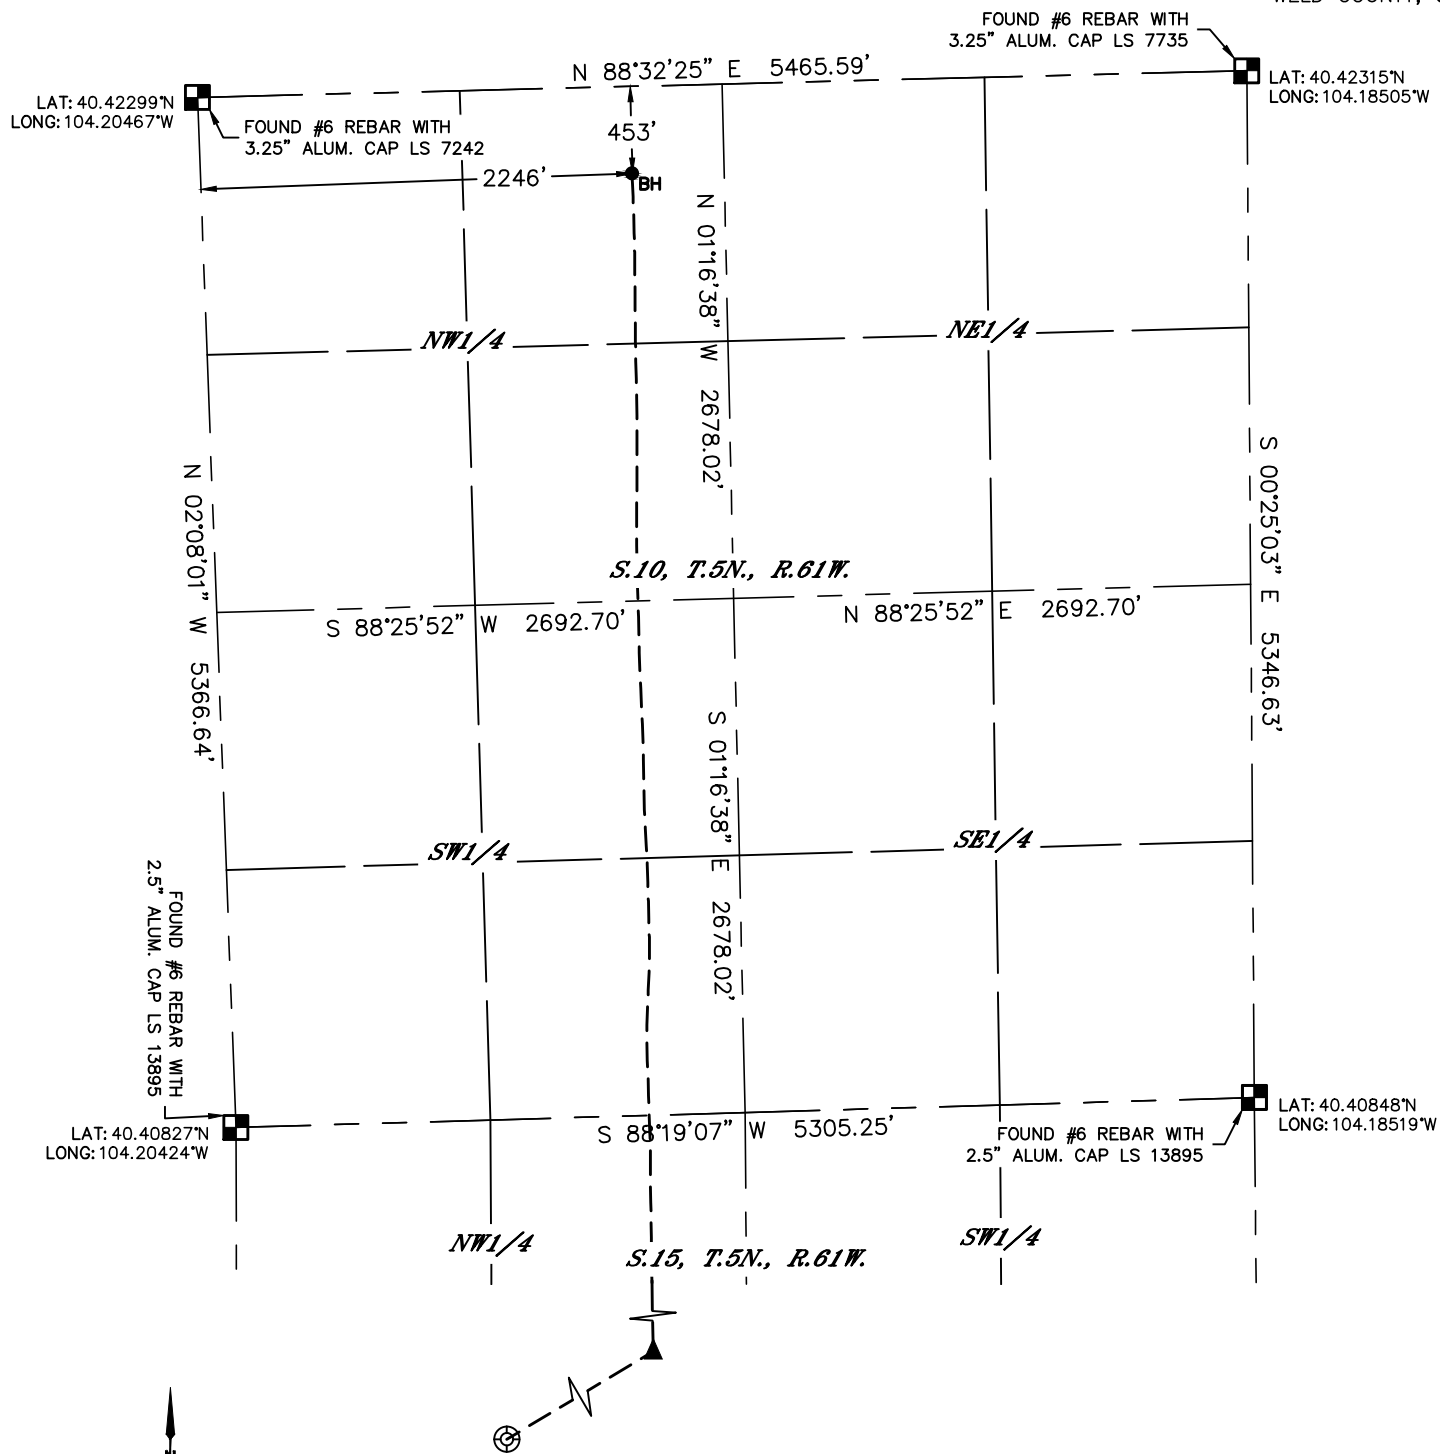PRONGHORN 024-15-10XRLNB

SECTION: 15
TOWNSHIP: 5N
RANGE: 61W
6TH. P.M.
WELD COUNTY, CO



LEGEND

-  = ALIQUOT MONUMENT AS DESCRIBED
 = CALCULATED POSITION
 = EXISTING WELL
 = 7" CASING POINT LOCATION (CP)
 = BOTTOM HOLE LOCATION (BHL)



SHEET 2 OF 2

Kyle E. Rutz—On behalf of Lat40°, Inc.
Colorado Licensed Professional Surveyor No. 38307
DATE: 04/29/2014
PROJECT#: 2012073