


# SECTION 16, TOWNSHIP 2 NORTH, RANGE 65 WEST, 6TH P.M.

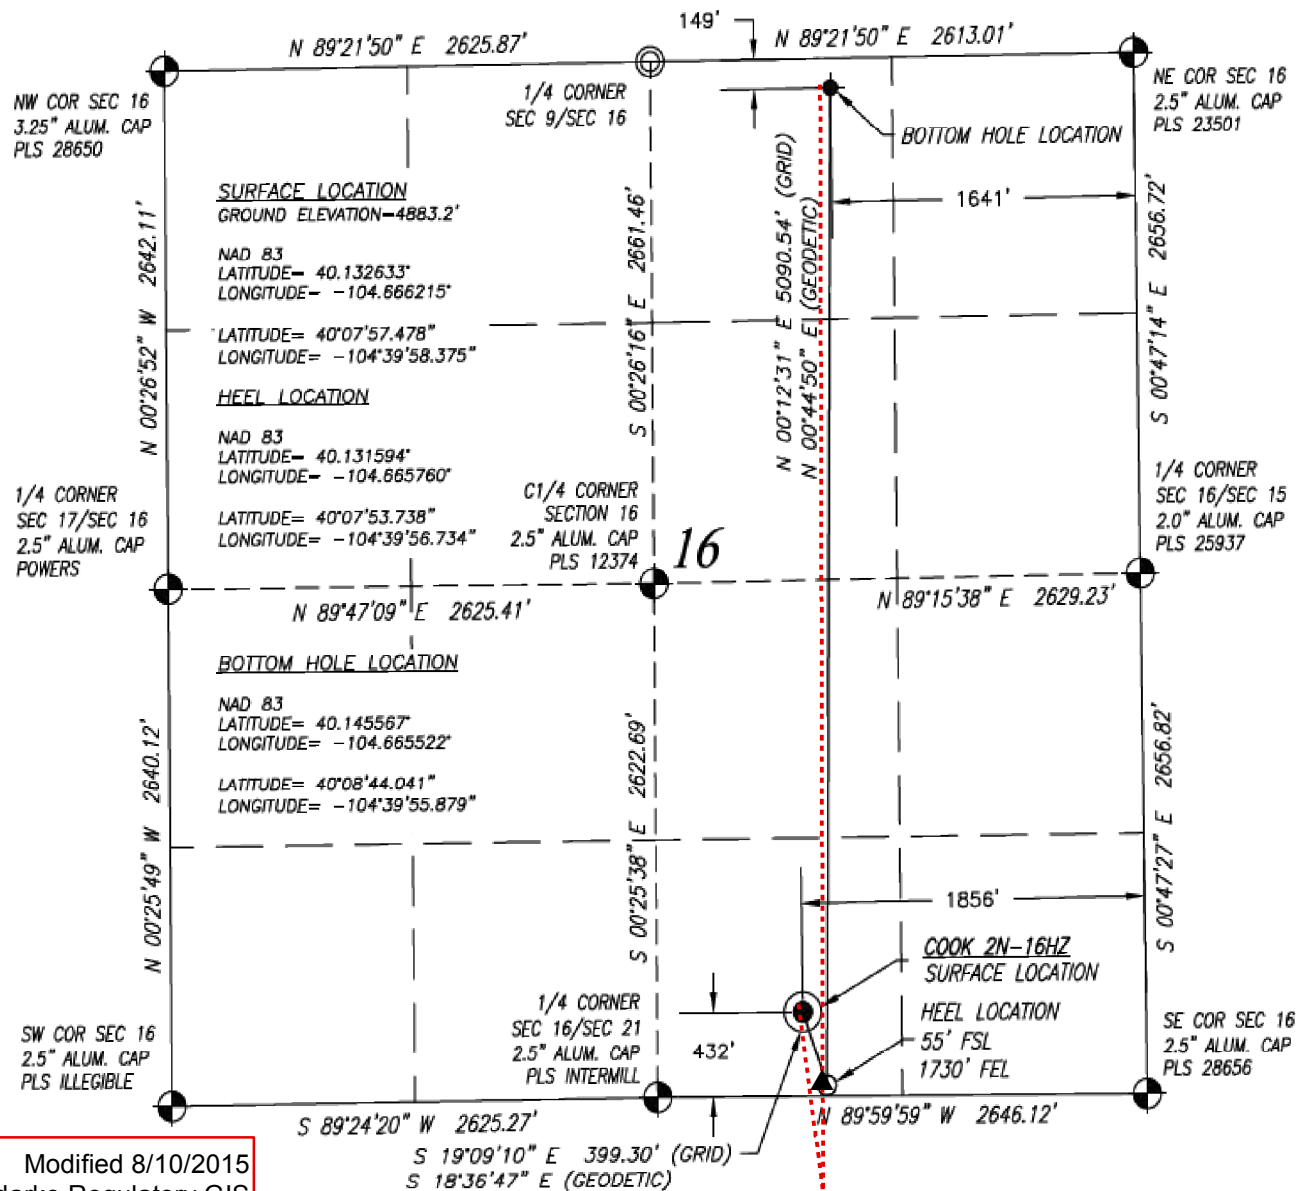

Modified 8/10/2015  
Anadarko Regulatory GIS  
KMJ  
(PAGE 1 OF 2)



**SURVEYOR'S CERTIFICATION:**  
I, hereby certify to KERR-McGEE OIL & GAS ONSHORE L.P., that this Well Location Certificate was prepared under my direct supervision and that the drawing accurately depicts the proposed location of the well.

Mark A. Hall, PLS #36073  
FOR AND ON BEHALF OF ACKLAM, INC.  
195 Telluride Street Suite 7  
Brighton CO 80601



--- PROPOSED WELL BORE

▲ PROPOSED HEEL

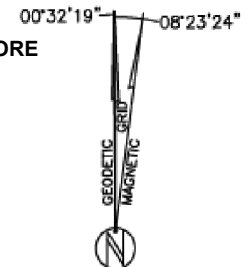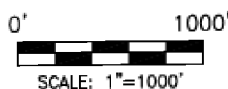

EQUATION:  
MAGNETIC AZIMUTH=GRID AZIMUTH-08°23'24"  
GEODETIC AZIMUTH=GRID AZIMUTH+00°32'19"

## NOTES:

- Found Section Corner
  - Calculated Section Corner
  - Basis of Elevations: NAVD88 (GEOID12).
  - Basis of Bearings: Colorado coordinate system 1983 north zone ('GRID').
  - Basis of Distances: GRID; Combined Factor=0.999728637
  - GPS Operator: M.W. PDOP < 3.0
  - See attachments for existing improvements within 500 feet of the well pad.
  - Well footages are measured at right angles to the section lines.
  - The Bottom Hole Location bears N 01°49'02" E 4715.68' from the Surface Location.
- NOTICE: According to Colorado law you must commence any legal action based upon any defect in this survey within three years after you first discover such defect. In no event may any action based upon any defect in this survey be commenced more than ten years from the date of the certification shown hereon.

SHEET 1 OF 1

PREPARED FOR:



Kerr-McGee Oil & Gas Onshore L.P.  
1099 18th Street  
Denver, Colorado 80202

Acklam, Inc.

DATE SURVEYED: 12/15/2014

DATE DRAFTED: 03/06/2015

DRAFTED BY: PAV CHK BY: MAH

JOB No. 14506

REVISED: 4/27/2015

## WELL LOCATION CERTIFICATE

### COOK 2N-16HZ


SURFACE 432' FSL 1856' FEL SEC. 16  
GROUND ELEVATION=4883.2'

HEEL 55' FSL 1730' FEL SEC. 16  
BOTTOM 149' FNL 1641' FEL SEC. 16

SW 1/4 SE 1/4  
SECTION 16, T2N, R65W, 6TH PM  
WELD COUNTY, COLORADO

# PLAT ADDENDUM: COOK 2N-16HZ

SECTION 21, TOWNSHIP 2 NORTH, RANGE 65 WEST, 6TH P.M.

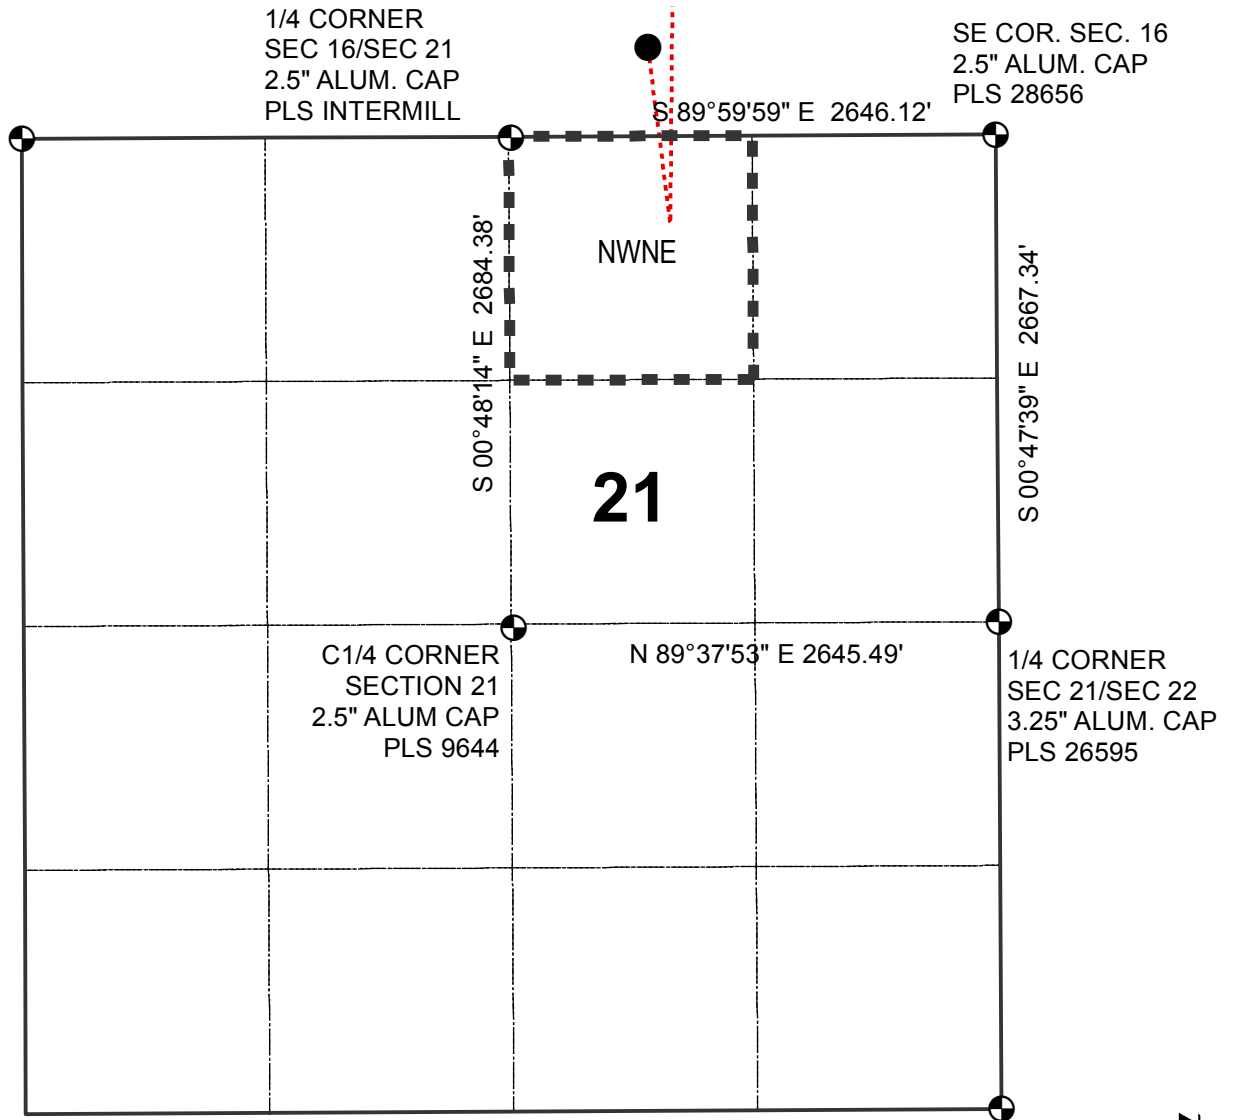

## LEGEND

- CALCULATED POSITION
- PROPOSED WELL
- ⊕ EXISTING MONUMENT
- ..... BACK BUILD

0 500 1,000  
Feet



Modified 8/10/2015  
Anadarko Regulatory GIS  
KMJ  
(PAGE 2 OF 2)