

Physical Address: 345 Comanche St.
 Mail to: Box 384 Kiowa, CO 80117
 Ph. 303-621-8672 - Fax 303-621-7749
 www.highprairiesurvey.com

Job: 14155 GOOD DEAL #13

Inv # 3185

High Prairie Surveying of Kiowa, Colorado, in accordance with a request from **Wiepking Fullerton Energy, LLC**, has determined the location of **GOOD DEAL #13** to be **810 feet FSL**, and **660 feet FWL**, (90° off Section lines) of SECTION 16, Township 10s, Range 55w of the 6th Principal Meridian, Lincoln County, Colorado.

Date: Staked on 05/21/14 drawn on 05/22/14.


Re: Staked by Elijah Frane

Drawn: Drawn by Dustin Cotter

Basis of Elevation Spot: USGS BM = E 25, PID = KJ0219, H-Order = First, V-Order = First, Stability = 8, Sats = 8, US NAD 83 CO-C, Lat. = 39.21461, Long. = W103.60209, Elevation = 5248.17 gr. (us FT)

Notes: See Location Drawing for improvements within 500' of the proposed well pad.
 The ground elevation at staked location = 5165.02' gr.
 This drawing does not represent a monumented survey or Land Survey Plat.

Basis of Bearing: Bearings were determined based on the West line of Section 16 to bear N00°35'52"W with all other bearings contained herein relative thereto.

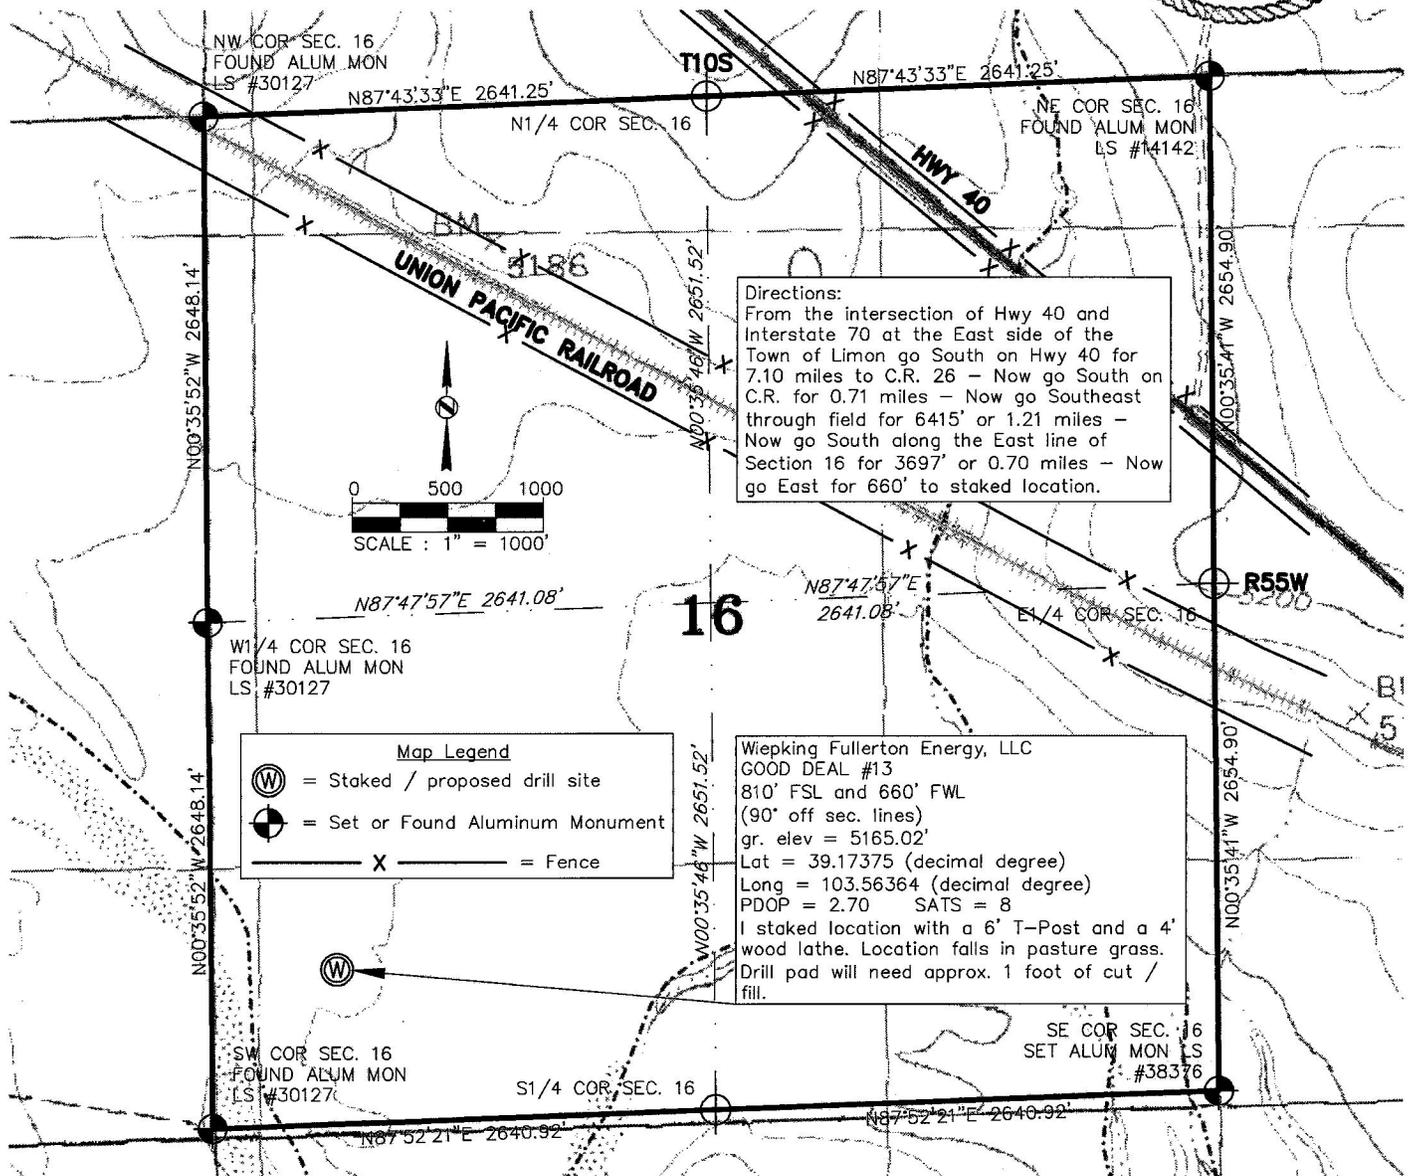

Directions:
 From the intersection of Hwy 40 and Interstate 70 at the East side of the Town of Limon go South on Hwy 40 for 7.10 miles to C.R. 26 - Now go South on C.R. for 0.71 miles - Now go Southeast through field for 6415' or 1.21 miles - Now go South along the East line of Section 16 for 3697' or 0.70 miles - Now go East for 660' to staked location.

Map Legend
 (W) = Staked / proposed drill site
 (A) = Set or Found Aluminum Monument
 X = Fence

Wiepking Fullerton Energy, LLC
 GOOD DEAL #13
 810' FSL and 660' FWL
 (90° off sec. lines)
 gr. elev = 5165.02'
 Lat = 39.17375 (decimal degree)
 Long = 103.56364 (decimal degree)
 PDOP = 2.70 SATS = 8
 I staked location with a 6' T-Post and a 4' wood lathe. Location falls in pasture grass. Drill pad will need approx. 1 foot of cut / fill.