

Physical Address: 345 Comanche St.
Mail to: Box 384 Kiowa, CO 80117
Ph. 303-621-8672 - Fax 303-621-7749
www.highprairiesurvey.com

Job: 14155 GOOD DEAL #13


Inv # 3185

High Prairie Surveying of Kiowa, Colorado, in accordance with a request from **Wiepking Fullerton Energy, LLC**, has determined the location of **GOOD DEAL #13** to be **810 feet FSL**, and **660 feet FWL**, (90° off Section lines) of **SECTION 16**, Township **10s**, Range **55w** of the 6th Principal Meridian, **Lincoln County, Colorado**.

Date: Staked on 05/21/14 drawn on 05/22/14.

Re: Staked by Elijah Frane

Drawn: Drawn by Dustin Conner

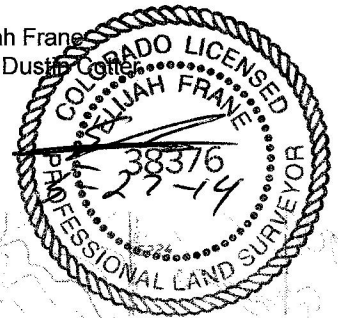

Access Road Map

