

Physical Address: 345 Comanche St.
Mail to: Box 384 Kiowa, CO 80117
Ph. 303-621-8672 - Fax 303-621-7749
www.highprairiesurvey.com

Job: 14155 GOOD DEAL #13


Inv # 3185

High Prairie Surveying of Kiowa, Colorado, in accordance with a request from Wiepking Fullerton Energy, LLC, has determined the location of GOOD DEAL #13 to be 810 feet FSL, and 660 feet FWL, (90° off Section lines) of SECTION 16, Township 10s, Range 55w of the 6th Principal Meridian, Lincoln County, Colorado.

Date: Staked on 05/21/14 drawn on 05/22/14.

Re: Staked by Elijah Frane

Drawn: Drawn by Dustin Carter

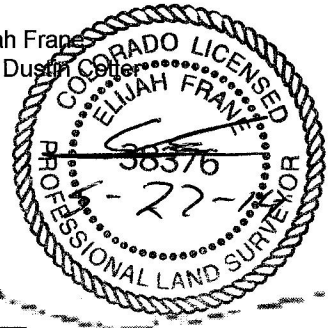

500' Location Drawing

There are no apparent improvements within 1000' of the proposed well pad.

WIEPKING FULLERTON
SW1/4 SEC. 16-10s-55w
GOOD DEAL #13
LINCOLN COUNTY, COLORADO

