


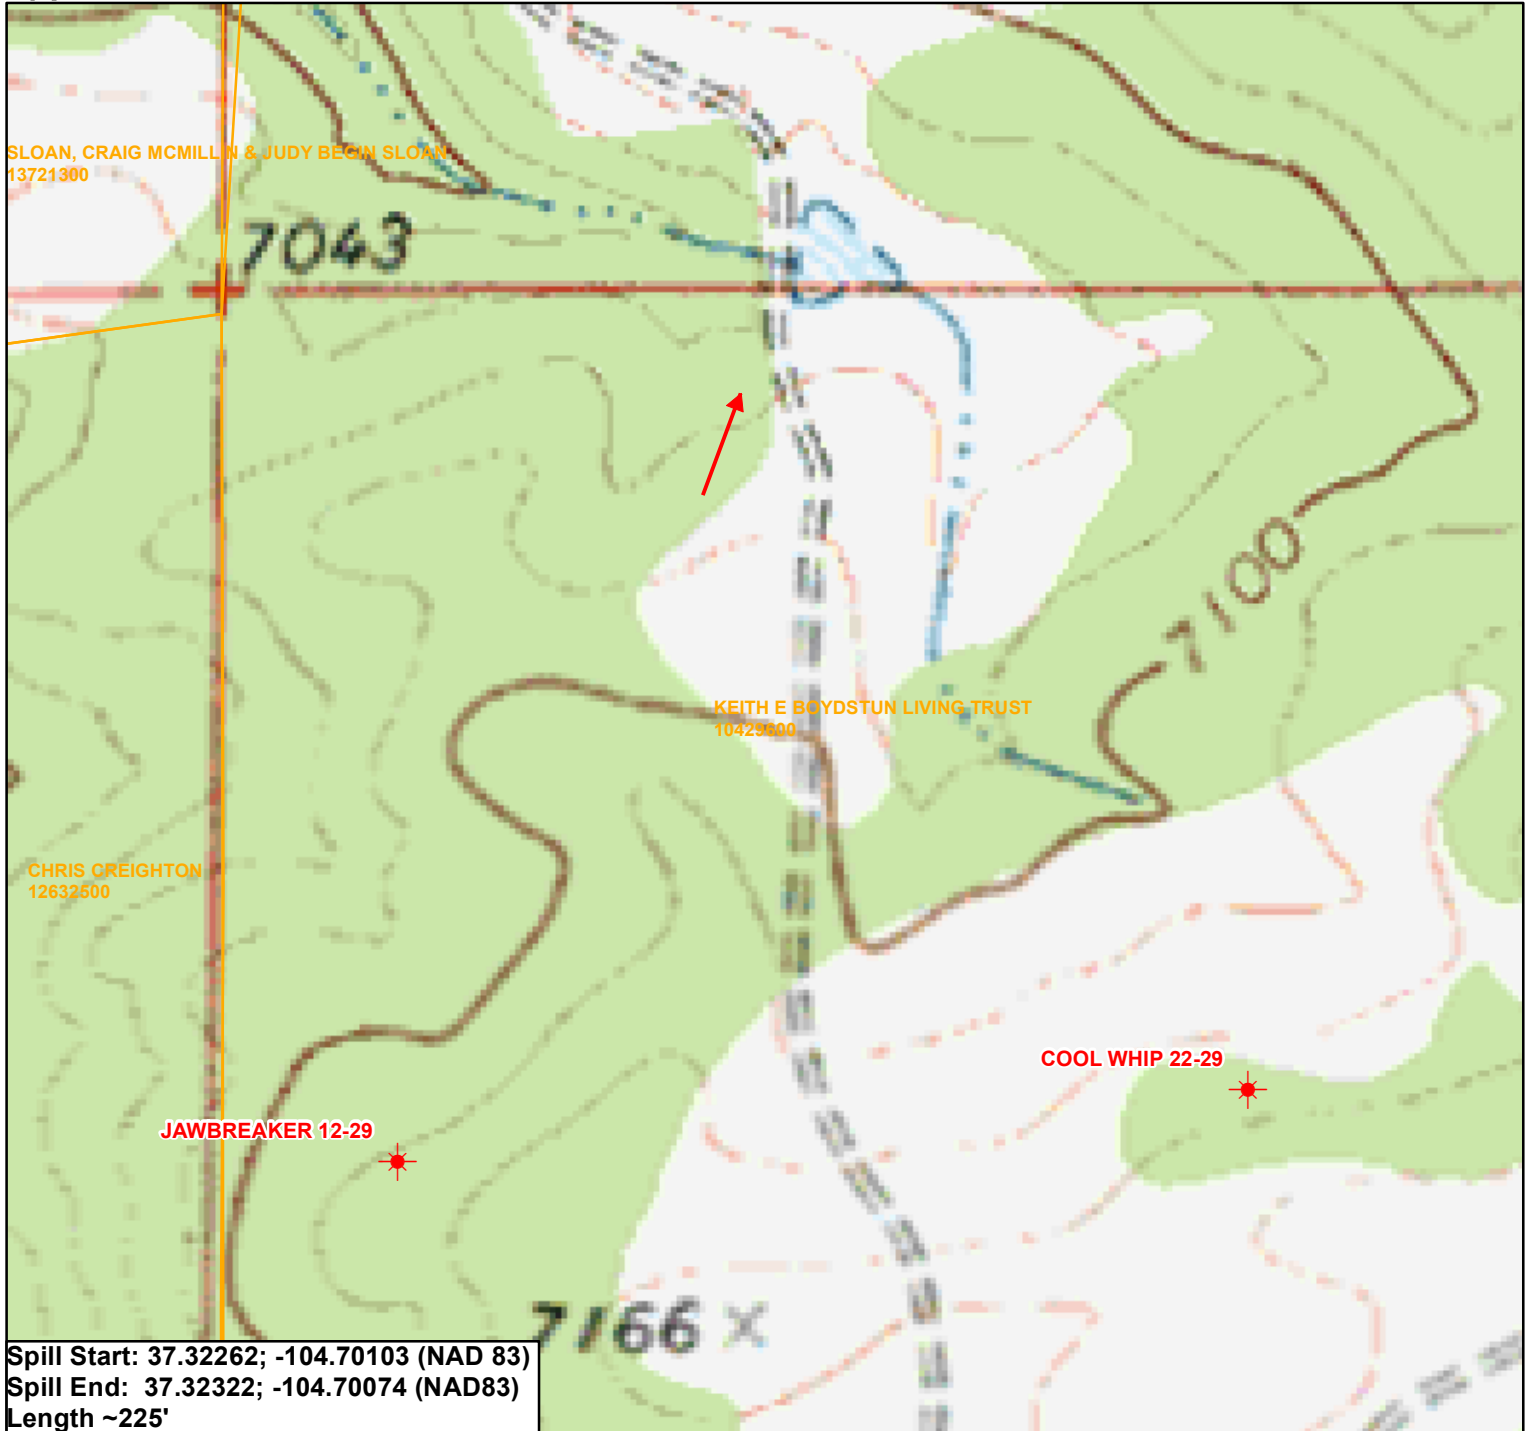

# Topographic Spill Map

## Cool Whip22-29 Spill

**PIONEER**  
NATURAL RESOURCES



★ Permitted Well

→ Spill Path

0 250 500 750 1,000 Feet

1:5,000